

MISSISSIPPI DEPARTMENT OF NATURAL RESOURCES

Bureau of Land and Water Resources

Southport Mall

P.O. Box 10631

Jackson, Mississippi 39209

WATER WELL DRILLERS LOG

CODED

Washington
H99
5/11/82
5-11-82

date well completed

firm name

county well located

Schultz Drilling Wash.

LANDOWNER: <u>Leon Lumley</u> <u>Wilmont Rd</u> <u>Greenville MS</u> (mailing address)	description of formations encountered	from	to
	<u>Clay</u>	<u>0</u>	<u>20</u>
	<u>Coarse SAND</u>	<u>20</u>	<u>72</u>
CODED			
WELL LOCATION: sec. <u>28</u> T. <u>17</u> R. <u>7</u> <u>4</u> miles ^S <u>N</u> of <u>Acacah</u> (distance) (direction) (nearest town)			
WELL PURPOSE: <u>IRRIGATION</u> (home, irrigation, municipal, industrial)			
WELL COMPLETION DATA:			
(1) diameter (inches) <u>10"</u>			
(2) total depth (feet) <u>72'</u>			
(3) static water level (feet) <u>22</u> ^{below} above top of ground.			
(4) casing <u>PVC</u> <u>42'</u> (material) (depth)			
(size) if telescope see back.			
(5) screen <u>30'</u> <u>42'</u> (length) (depth to top)			
<u>10"</u> <u>PVC slotted</u> (size) (material)			
(6) pump <u>15</u> <u>700</u> (HP) (yield gpm)			
<u>ele</u> (type power)			
(7) electric log <u>NO</u> (yes or no)			
(organization running log)			
(8) how well bottom plugged <u>pvc cap</u>			

DEPT. OF NATURAL RESOURCES
BUREAU OF LAND & WATER RESOURCES


MAY 24 1982

RECEIVED

DRILLERS REMARKS:

If well telescopes please sketch and show depths.

GROUND LEVEL

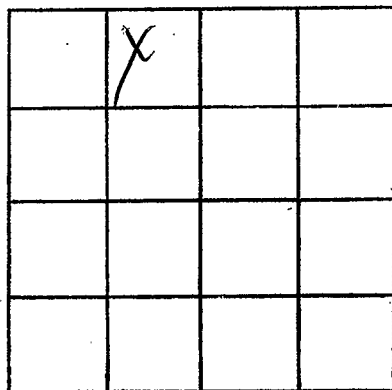

SECTION _____

Please indicate well location X.

ADDITIONAL INFORMATION

If more than one screen,
show locations of each on sketch.