

MISSISSIPPI DEPARTMENT OF NATURAL RESOURCES

Bureau of Land and Water Resources

Southport Mall

P.O. Box 10631

Jackson, Mississippi 39209

WATER WELL DRILLERS LOG

CODED

Washington  
H. 100  
5712182

5-12 1982 Schultz Drilling WASH  
date well completed firm name county well located

LANDOWNER: Aqua Farms  
Wilmont Rd.  
Greenville MS  
(mailing address)

description of formations encountered	from to	
Clay	0	20
COARSE SAND	20	40
COARSE SAND and PER GRAVEL	40	85

WELL LOCATION:  
sec 21 T 17 N R 7 E  
S W  
5 miles NW of Arcola  
(distance) (direction) (nearest town)

WELL PURPOSE: Irrigation  
(home, irrigation, municipal, industrial)

WELL COMPLETION DATA:

(1) diameter (inches) 10"

(2) total depth (feet) 82'

(3) static water level (feet) 22' below top of ground.

(4) casing PVC 42'  
(material) (depth)

(size) If telescope see back.

(5) screen 40' 42'  
(length) (depth to top)

10" PVC slotted  
(size) (material)

(6) pump 20 800  
(HP) (yield gpm)

elk  
(type power)

(7) electric log NO  
(yes or no)

(organization running log)

(8) how well bottom plugged PVC cap

DRILLERS REMARKS:

CODED


DEPT. OF NATURAL RESOURCES  
BUREAU OF LAND & WATER RESOURCES

MAY 24 1982

RECEIVED

If well telescopes please sketch and show depths.

GROUND LEVEL

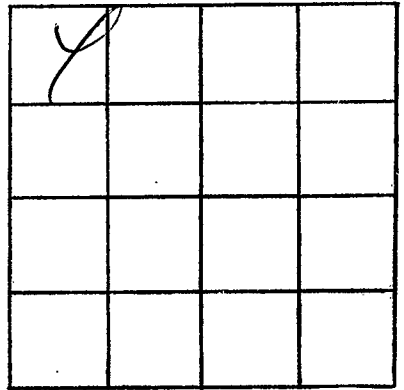

SECTION \_\_\_\_\_

Please indicate well location X.

ADDITIONAL INFORMATION

If more than one screen,  
show locations of each on sketch.