

MISSISSIPPI DEPARTMENT OF NATURAL RESOURCES

Bureau of Land and Water Resources

Southport Mall

P.O. Box 10631

Jackson, Mississippi 39209

WATER WELL DRILLERS LOG

CODED

Washington
H101
3/12/82

3/12 1982 Larry's well & pump Washington
date well completed firm name county well located

LANDOWNER: Harry Branton
Leland MS.
(mailing address)

description of formations encountered	from	to
<u>clay</u>	<u>0</u>	<u>20</u>
<u>fine sand</u>	<u>20</u>	<u>40</u>
<u>med sand</u>	<u>40</u>	<u>92</u>

WELL LOCATION:
sec. 4 T. 17 N. R. 7 E.
S. W.
3 miles South of Leland
(distance) (direction) (nearest town)

CODED

WELL PURPOSE:
(home, irrigation, municipal, industrial)

WELL COMPLETION DATA:

- (1) diameter (inches) 12"
- (2) total depth (feet) 92'
- (3) static water level (feet) 20' below
top of ground. above
- (4) casing Steel, 52'
(material) (depth)
 If telescope see back.
(size)
- (5) screen 40', 52'
(length) (depth to top)
12", steel
(size) (material)
- (6) pump 30, 1500
(HP) (yield gpm)

(type power)
- (7) electric log NO
(yes or no)

(organization running log)

(8) how well bottom plugged Steel
Plate

DRILLERS REMARKS:


DEPT. OF NATURAL RESOURCES
BUREAU OF LAND & WATER RESOURCES

JUN 21 1982

RECEIVED

If well telescopes please sketch and show depths.

GROUND LEVEL

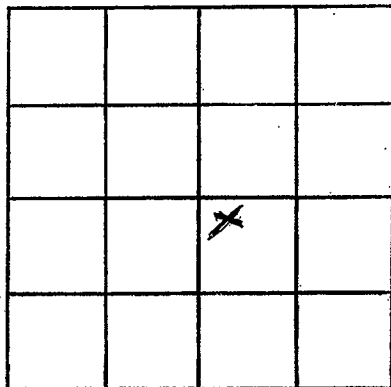

SECTION 4

Please indicate well location X.

ADDITIONAL INFORMATION

If more than one screen,
show locations of each on sketch.