

MISSISSIPPI DEPARTMENT OF NATURAL RESOURCES

Bureau of Land and Water Resources

Southport Mall

P.O. Box 10631

Jackson, Mississippi 39209

WATER WELL DRILLERS LOG

CODED

H103
WASHINGTON
7-19-83

7-19-83 date well completed Schultz Drilling firm name Washington county well located

LANDOWNER:
AQUA FARMS
Greenville MS
(mailing address)

description of formations encountered	from	to
CLAY	0	30
SAND	30	40
COARSE SAND	40	60
COARSE SAND + PER GRAVEL	60	90

WELL LOCATION:
sec. 29 T. 17 N. R. 7 E. S. 7 W.
7 miles SE of Greenville
(distance) (direction) (nearest town)

WELL PURPOSE: IRRIGATION
(home, irrigation, municipal, industrial)

- WELL COMPLETION DATA:
- (1) diameter (inches) 16"
 - (2) total depth (feet) 90'
 - (3) static water level (feet) 20' below top of ground.
 - (4) casing PVC 50' (material) (depth)
 - (5) screen 40' 50' (length) (depth to top)
 - 16" PVC (size) (material)
 - (6) pump 40' 1050 (HP) (yield gpm)
 - ele (type power)
 - (7) electric log NO (yes or no)
 - X (organization running log)
 - (8) how well bottom plugged cap

CODED

DEPT. OF NATURAL RESOURCES
BUREAU OF LAND & WATER RESOURCES


AUG 11 1983

RECEIVED

DRILLERS REMARKS:

If well telescopes please sketch and show depths.

GROUND LEVEL

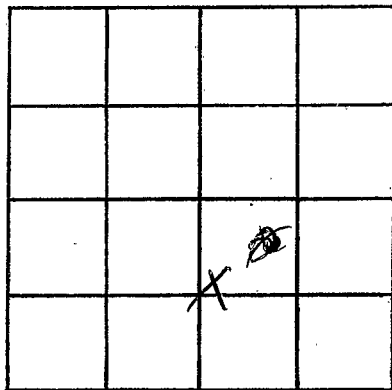

SECTION 29

Please indicate well location X.

ADDITIONAL INFORMATION

If more than one screen,
show locations of each on sketch.