

MISSISSIPPI DEPARTMENT OF NATURAL RESOURCES

Bureau of Land and Water Resources

Southport Mall

P.O. Box 10631

Jackson, Mississippi 39209

WATER WELL DRILLERS LOG

CODED

H104  
 WASHINGTON  
 7-18-83

7-18-83 19 date well completed Schultz Drilling firm name Washington county well located

LANDOWNER:  
 AQUA FARMS  
 Greenville MS  
 (mailing address)

description of formations encountered	from	to
Clay	0	30
SAND	30	40
COARSE SAND	40	60
COARSE SAND + pea gravel	60	85

WELL LOCATION:  
 sec. 29 T. 17 N. R. 7 E. S. W.  
 7 miles SE of Greenville  
 (distance) (direction) (nearest town)

WELL PURPOSE: IRRIGATION  
 (home, irrigation, municipal, industrial)

WELL COMPLETION DATA:

(1) diameter (inches) 12"

(2) total depth (feet) 85'

(3) static water level (feet) 20' below top of ground.

(4) casing PVC, 45' (material) (depth)

(size) If telescope see back.

(5) screen 40' 45' (length) (depth to top)

12" PVC (size) (material)

(6) pump 30 950 (HP) (yield gpm)

ele (type power)

(7) electric log NO (yes or no)

X (organization running log)

(8) how well bottom plugged cap

CODED

DEPT. OF NATURAL RESOURCES  
 BUREAU OF LAND & WATER RESOURCES


AUG 11 1983

RECEIVED

DRILLERS REMARKS:

If well telescopes please sketch and show depths.

GROUND LEVEL

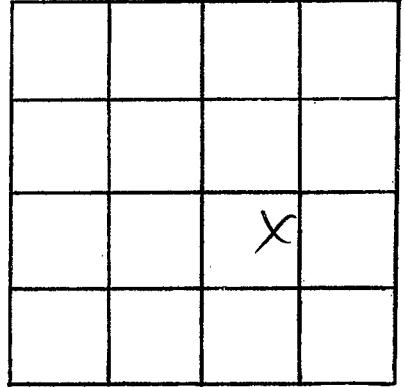

SECTION 29

Please indicate well location X.

ADDITIONAL INFORMATION

If more than one screen,  
show locations of each on sketch.