

H 105

MISSISSIPPI
BOARD OF WATER COMMISSIONERS
416 North State Street
Jackson, Mississippi 39201

CODED

9-9-83

WATER WELL DRILLERS LOG

9-9 1983 Schultz Drilling Washington
date well completed firm name county well located

LANDOWNER: Gene Dennis
Leland MS

description of formations encountered

from to

(mailing address)

CLAY 0 21
SAND 21 40
SAND + GRAVEL 40 80

WELL LOCATION:

sec. 16 T 17 S R 7 E
5 miles S of Leland
(distance) (direction) (nearest town)

CODED

WELL PURPOSE: IRRIGATION
(home, irrigation, municipal, industrial)

WELL COMPLETION DATA:

- (1) diameter (inches) 10"
- (2) total depth (feet) 80'
- (3) static water level (feet) 21' -below above top of ground.
- (4) casing PVC 40'
(material) (depth)
- (size) if telescope see back.
- (5) screen 40' 40'
(length) (depth to top)
- 10" PVC
(size) (material)
- (6) pump 20 1000
(HP) (yield gpm)
- elb
(type power)
- (7) electric log NO
(yes or no)
- X
(organization running log)
- (8) how well bottom plugged CAP

DEPT. OF NATURAL RESOURCES
BUREAU OF LAND & WATER RESOURCES


SEP 26 1983

RECEIVED

DRILLERS REMARKS:

If well telescopes please sketch and show depths.

GROUND LEVEL

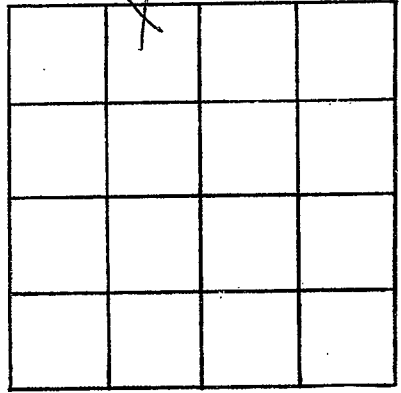

SECTION _____

Please indicate well location X.

ADDITIONAL INFORMATION

If more than one screen, show locations of each on sketch.