

H 106
 Washington
 CI-2362
 4-21-83

MISSISSIPPI DEPARTMENT OF NATURAL RESOURCES
 Bureau of Land and Water Resources
 Southport Mall
 P.O. Box 10631
 Jackson, Mississippi 39209
WATER WELL DRILLERS LOG

CODED

4-21 1983 LAYNE-CENTRAL CO. WASHINGTON
 date well completed firm name county well located

LANDOWNER: L & L FARMS
 AVON, MS
 (mailing address)

description of formations encountered	from	to
clay	0.	32
coarse sand	32	50
c. sand & gravel	50	120

WELL LOCATION:
 sec. 23 T 17 N R. 7 E
 W
 1 miles N of Wilmot
 (distance) (direction) (nearest town)

WELL PURPOSE: irrigation
 (home, irrigation, municipal, industrial)

WELL COMPLETION DATA:
 (1) diameter (inches) 28"
 (2) total depth (feet) 130'
 (3) static water level (feet) 26' below top of ground.
 (4) casing steel, 80' (material), (depth), 12" (size) if telescope see back.
 (5) screen 40' (length), 80' (depth to top), 12" (size), st. st. (material)
 (6) pump 40 (HP), 1600 (yield gpm), diesel (type power)
 (7) electric log no (yes or no)
 (organization running log) st. plate
 (8) how well bottom plugged

DRILLERS REMARKS:


DEPT. OF NATURAL RESOURCES
 BUREAU OF LAND & WATER RESOURCES

OCT 10 1983

RECEIVED

If well telescopes please sketch and show depths.

GROUND LEVEL

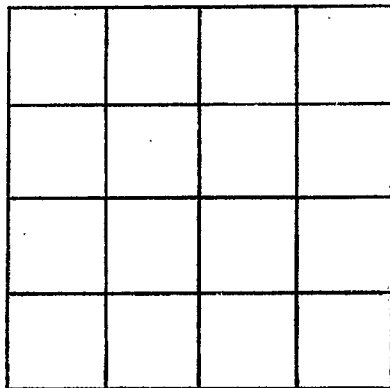

SECTION _____

Please indicate well location X.

ADDITIONAL INFORMATION

If more than one screen,
show locations of each on sketch.