

H107  
 WASHINGTON  
 FACILITY  
 10-20-83

MISSISSIPPI  
 BOARD OF WATER COMMISSIONERS  
 416 North State Street  
 Jackson, Mississippi 39201

CODED

WATER WELL DRILLERS LOG

10-20 1983 Schultz Drilling Washington  
 date well completed firm name county well located

LANDOWNER:  
 AQUA FARMS  
 GREENVILLE MS  
 (mailing address)

description of formations encountered	from	to
Clay	0	25
Med SANDING	25	40
COARSE SAND	40	80
small pea gravel		

WELL LOCATION:  
 sec. 20 T. 17 N. R. 7 E  
 7 miles S of Greenville  
 (distance) (direction) (nearest town)

WELL PURPOSE: IRRIGATION  
 (home, irrigation, municipal, industrial)

- WELL COMPLETION DATA:
- diameter (inches) 10"
  - total depth (feet) 80'
  - static water level (feet) 31' below top of ground.
  - casing PVC 40' (material) (depth)
  - screen 40' 40' (length) (depth to top)  
 10" PVC (size) (material)
  - pump 15 750 (HP) (yield gpm)  
 ele (type power)
  - electric log NO (yes or no)  
 X (organization running log)
  - how well bottom plugged CAP


DRILLERS REMARKS:

DEPT. OF NATURAL RESOURCES  
 BUREAU OF LAND & WATER RESOURCES

NOV 14 1983  
 RECEIVED

If well telescopes please sketch and show depths.

GROUND LEVEL

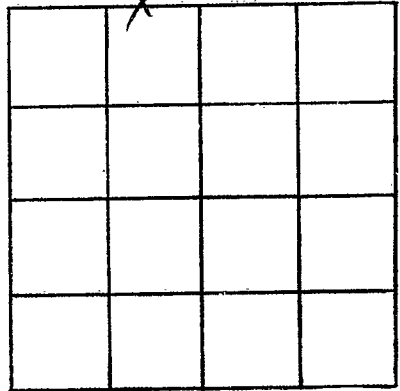

SECTION 20

Please indicate well location X.

ADDITIONAL INFORMATION

If more than one screen, show locations of each on sketch.