

MISSISSIPPI DEPARTMENT OF NATURAL RESOURCES

Bureau of Land and Water Resources

Southport Mall

P.O. Box 10631

Jackson, Mississippi 39209

CODE

WATER WELL DRILLERS LOG

Schultz Drilling Washington

H 108
WASHINGTON
5-4-84
5-4 1984

date well completed

firm name

county well located

LANDOWNER:

HEPPEL FARMS

Hollandale MS

(mailing address)

description of formations encountered

from

to

Clay	0	21
COARSE SAND	21	40
COARSE SAND +	40	74
PCA gravel		

WELL LOCATION:

sec. 17 T. 17 N. R. 7 E. S. 4 W. of Arcola
(distance) miles (direction) of (nearest town)

WELL PURPOSE: IRRIGATION
(home, irrigation, municipal, industrial)

WELL COMPLETION DATA:

- (1) diameter (inches) 10"
- (2) total depth (feet) 74'
- (3) static water level (feet) 18' below top of ground.
- (4) casing PVC 44' (material), (depth)
- (5) screen 30' 44' (length), (depth to top) 10" PVC (size), (material)
- (6) pump 20 1000 (HP), (yield gpm) ele (type power)
- (7) electric log X (yes or no) (organization running log)
- (8) how well bottom plugged PVC CAP

DRILLERS REMARKS:


DEPT. OF NATURAL RESOURCES
BUREAU OF LAND & WATER RESOURCES

MAY -7 1984

RECEIVED

If well telescopes please sketch and show depths.

GROUND LEVEL

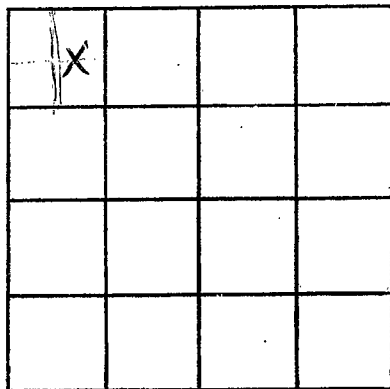

SECTION 17.

Please indicate well location X.

ADDITIONAL INFORMATION

If more than one screen,
show locations of each on sketch.