

MISSISSIPPI DEPARTMENT OF NATURAL RESOURCES

Bureau of Land and Water Resources

Southport Mall

P.O. Box 10631

Jackson, Mississippi 39209

WATER WELL DRILLERS LOG

CODED

H109
 WASHINGTON
 5-4-84

5-4 1984 Schultz Drilling Washington
 date well completed firm name county well located

LANDOWNER:	description of formations encountered	from	to
Herren Farms Hollandale MS (mailing address)			
WELL LOCATION: sec. 7 T 17 N R 7 E 4 miles W of Arcola (distance) (direction) (nearest town)			
WELL PURPOSE: IRRIGATION (home, irrigation, municipal, industrial)			
WELL COMPLETION DATA: (1) diameter (inches) 10" (2) total depth (feet) 71' (3) static water level (feet) 18' below top of ground. (4) casing PVC 41' (material) (depth) if telescope see back. (5) screen 30' 41' (length) (depth to top) 10' PVC (size) (material) (6) pump 20 1000 (HP) (yield gpm) ele (type power) (7) electric log X (yes or no) X (organization running log) (8) how well bottom plugged PVC CRIP			
DRILLERS REMARKS:			


CODED

DEPT. OF NATURAL RESOURCES
 BUREAU OF LAND & WATER RESOURCES

MAY - 7 1984
 RECEIVED

If well telescopes please
sketch and show depths.

GROUND LEVEL

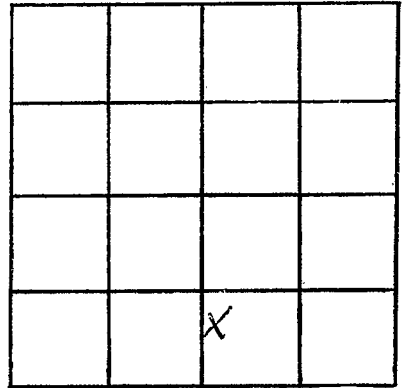

SECTION 7

Please indicate well location X.

ADDITIONAL INFORMATION

If more than one screen,
show locations of each on sketch.