

MISSISSIPPI DEPARTMENT OF NATURAL RESOURCES  
 Bureau of Land and Water Resources  
 Southport Mall  
 P.O. Box 10631  
 Jackson, Mississippi 39209  
**WATER WELL DRILLERS LOG**

**CODED**

Washington  
 H 111

5-18 19 84 Larrys Well & Pump Co. Washington Co.  
 date well completed firm name county well located

LANDOWNER: Wayne Davis  
Hollandale Miss

description of formations encountered	from	to
	<u>slay</u>	<u>0</u>
<u>Fine Sand</u>	<u>30</u>	<u>50</u>
<u>coarse Sand</u>	<u>50</u>	<u>80</u>

(mailing address)

WELL LOCATION:  
 sec. 28T-17N R. 7E  
5S 7W  
2 W miles 2 N of Arcola  
 (distance) (direction) (nearest town)

WELL PURPOSE:  
 (home, irrigation, municipal, industrial)

**CODED**

WELL COMPLETION DATA:

- (1) diameter (inches) 8"
- (2) total depth (feet) 80'
- (3) static water level (feet) 20 below above  
top of ground.
- (4) casing plastic, 40'  
(material) (depth)  
         if telescope see back.  
(size)
- (5) screen 40' - 40'  
(length) (depth to top)  
8", plastic  
(size) (material)
- (6) pump 20 1100  
(HP) (yield gpm)  
E  
(type power)
- (7) electric log no  
(yes or no)  
          
(organization running log)
- (8) how well bottom plugged cap

DEPT. OF NATURAL RESOURCES  
 BUREAU OF LAND & WATER RESOURCES


SEP 10 1984

**RECEIVED**

DRILLERS REMARKS:

If well telescopes please sketch and show depths.

GROUND LEVEL

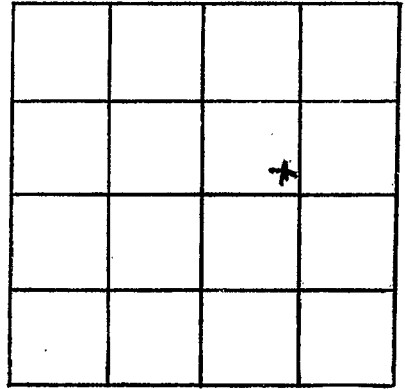

SECTION 28

Please indicate well location X.

ADDITIONAL INFORMATION

If more than one screen,  
show locations of each on sketch.