

MISSISSIPPI DEPARTMENT OF NATURAL RESOURCES
Bureau of Land and Water Resources
 Southport Mall
 P.O. Box 10631
 Jackson, Mississippi 39209
WATER WELL DRILLERS LOG

CODED

Washington
H 112

5-16 19 84 Long Well Pump Co. Washington
 date well completed firm name county well located

LANDOWNER: Harry Brunton
Belair, ms

description of formations encountered

from to

(mailing address)

<u>clay</u>	<u>0</u>	<u>20</u>
<u>Fine Sand</u>	<u>20</u>	<u>30</u>
<u>course Sand</u>	<u>30</u>	<u>80</u>

WELL LOCATION:

sec. 8 T. 17 N. R. 7 E.
S W
5 W miles 3 W of Arcola
 (distance) (direction) (nearest town)

WELL PURPOSE:

(home, irrigation, municipal, industrial)

CODED

WELL COMPLETION DATA:

- (1) diameter (inches) 8"
- (2) total depth (feet) 80'
- (3) static water level (feet) 22 below above top of ground.
- (4) casing plastic, 40' (material) (depth)
8" if telescope see back. (size)
- (5) screen 40', 40' (length) (depth to top)
8", plastic (size) (material)
- (6) pump 20, 1100 (HP) (yield gpm)
E (type power)
- (7) electric log no (yes or no)
 (organization running log)
- (8) how well bottom plugged cap

DEPT. OF NATURAL RESOURCES
 BUREAU OF LAND & WATER RESOURCES


SEP 10 1984

RECEIVED

DRILLERS REMARKS:

If well telescopes please sketch and show depths.

GROUND LEVEL

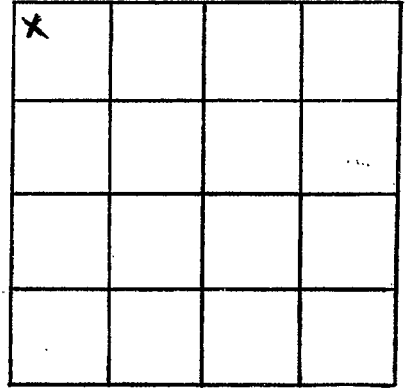

SECTION 8

Please indicate well location X.

ADDITIONAL INFORMATION

Lined area for additional information.

If more than one screen, show locations of each on sketch.