

MISSISSIPPI DEPARTMENT OF NATURAL RESOURCES
Bureau of Land and Water Resources
 Southport Mall
 P.O. Box 10631
 Jackson, Mississippi 39209
WATER WELL DRILLERS LOG

CODED

Washington
H 114

5-16 19 84 Larry Well & Pump Co Washington
 date well completed firm name county well located

LANDOWNER: Hary Benton
~~and~~
Leland, ms.
 (mailing address)

description of formations encountered	from	to
	<u>clay</u>	<u>0</u>
<u>fine sand</u>	<u>20</u>	<u>30</u>
<u>course sand</u>	<u>30</u>	<u>80</u>

WELL LOCATION:
 sec. 5 T. 17 N. R. 7 E.
 S. 7 W.
5 N miles 3 W of Arcole
 (distance) (direction) (nearest town)

CODED

WELL PURPOSE:
 (home, irrigation, municipal, industrial)

- WELL COMPLETION DATA:
- diameter (inches) 8"
 - total depth (feet) 80
 - static water level (feet) 20 below above top of ground.
 - casing plastic, 40'
(material) (depth)
8" if telescope see back.
(size)
 - screen 40", 40'
(length) (depth to top)
8", plastic
(size) (material)
 - pump 20 1100
(HP) (yield gpm)
E
(type power)
 - electric log no
(yes or no)
(organization running log)
 - how well bottom plugged cap

DEPT. OF NATURAL RESOURCES
 BUREAU OF LAND & WATER RESOURCES


SEP 10 1984

RECEIVED

DRILLERS REMARKS:

If well telescopes please sketch and show depths.

GROUND LEVEL

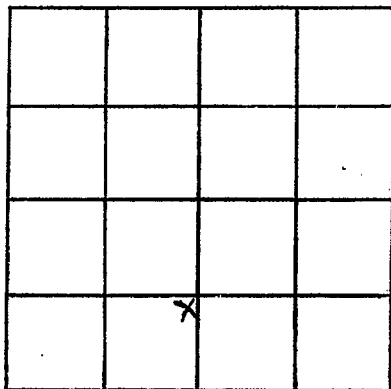

SECTION 5

Please indicate well location X.

ADDITIONAL INFORMATION

If more than one screen,
show locations of each on sketch.