

MISSISSIPPI DEPARTMENT OF NATURAL RESOURCES

Bureau of Land and Water Resources

Southport Mall<sup>0</sup>

P.O. Box 10631

Jackson, Mississippi 39209

WATER WELL DRILLERS LOG

CODES

WASHINGTON  
H 116

7-12-84  
date well completed

Schultz Drilling  
firm name

Washington  
county well located

LANDOWNER:	description of formations encountered	from	to
AQUA FARMS Greenville MS (mailing address)	CLAY MED. SAND COARSE SAND +	0 20 40	20 40 80
WELL LOCATION: sec. 20 T 17 N R 7 E 6 miles S of Greenville (distance) (direction) (nearest town)	SMALL pea gravel		
WELL PURPOSE: IRRIGATION (home, irrigation, municipal, industrial)			
WELL COMPLETION DATA:			
(1) diameter (inches) 10"			
(2) total depth (feet) 80'			
(3) static water level (feet) 32' below top of ground.			
(4) casing PVC 60' (material) (depth)			
_____ If telescope see back. (size)			
(5) screen 20' 60' (length) (depth to top)			
10" PVC (size) (material)			
(6) pump 15 750 (HP) (yield gpm)			
elo (type power)			
(7) electric log _____ (yes or no)			
_____ (organization running log)			
(8) how well bottom plugged PVC CAP			
DRILLERS REMARKS:			

CODED


DEPT. OF NATURAL RESOURCES  
BUREAU OF LAND & WATER RESOURCES

NOV 26 1984

RECEIVED

If well telescopes please sketch and show depths.

GROUND LEVEL

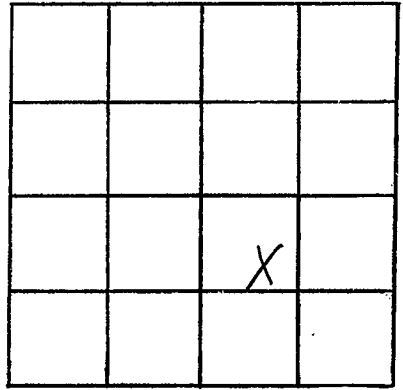

SECTION 20

Please indicate well location X.

ADDITIONAL INFORMATION

If more than one screen,  
show locations of each on sketch.