

MISSISSIPPI DEPARTMENT OF NATURAL RESOURCES
 Bureau of Land and Water Resources
 Southport Mall
 P.O. Box 10631
 Jackson, Mississippi 39209
WATER WELL DRILLERS LOG

CODED
CODE

WASHINGTON
 H 119
 GW 132

June 10, 1985 date well completed
 Larry's Well & Pump firm name
 Washington county well located

LANDOWNER: Lewis Mann
Leland mo
 (mailing address)


description of formations encountered	from	to
CLAY	0	28
FINE SAND	28	48
COARSE SAND & GRAVEL	48	106

WELL LOCATION:
 sec. 12 T. 12 N R. 7 E
4 miles S of Leland
 (distance) (direction) (nearest town)

WELL PURPOSE:
 (home, irrigation, municipal, industrial)

- WELL COMPLETION DATA:
- (1) diameter (inches) 12"
 - (2) total depth (feet) 106'
 - (3) static water level (feet) 24' ^{below} top of ground.
 - (4) casing Steel, 66',
 (material) (depth)
 (size) if telescope see back.
 - (5) screen 40', 66',
 (length) (depth to top)
12", Steel,
 (size) (material)
 - (6) pump 60 1200
 (HP) (yield gpm)
0
 (type power)
 - (7) electric log NO
 (yes or no)
 (organization running log)
 - (8) how well bottom plugged Steel Plate

CODED

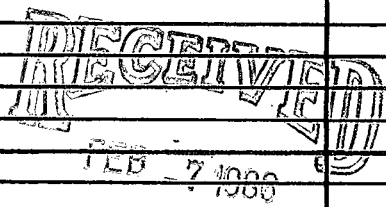


Department of Natural Resources
 Bureau of Land and Water Resources

DRILLERS REMARKS:

If well telescopes please sketch and show depths.

GROUND LEVEL

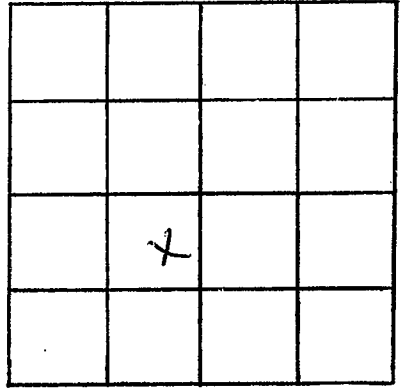

SECTION 12

Please indicate well location X.

ADDITIONAL INFORMATION

If more than one screen,
show locations of each on sketch.