

MISSISSIPPI DEPARTMENT OF NATURAL RESOURCES

Bureau of Land and Water Resources

Southport Mall

P.O. Box 10631

Jackson, Mississippi 39209

WATER WELL DRILLERS LOG

CODED

① WASHINGTON
 H 120

6-1

Schultz Drilling

Wash.

date well completed

firm name

county well located

LANDOWNER: Allen Spraggins

Regege Plantation

Greenville, MS

(mailing address)

description of formations encountered

from

to

CLAY
 SAND

0 25
 25 73

WELL LOCATION:

sec. 23 T. 17 S. R. 7 E. Leland
 8 miles S of (distance) (direction) (nearest town)

WELL PURPOSE: IRRIGATION
 (home, irrigation, municipal, industrial)

CODED

WELL COMPLETION DATA:

- (1) diameter (inches) 10'
- (2) total depth (feet) 73
- (3) static water level (feet) 39' below top of ground.
- (4) casing PVC 53 (material) (depth)
- (size) if telescope see back.
- (5) screen 20 53 (length) (depth to top)
- 10 PVC (size) (material)
- (6) pump 10 500 (HP) (yield gpm)
- ele (type power)
- (7) electric log No (yes or no)
- X (organization running log)
- (8) how well bottom plugged CAP

RECEIVED
 NOV 20 1985


DEC 3 - 1985

DRILLERS REMARKS:

Department of Natural Resources
 Bureau of Land & Water Resources

If well telescopes please sketch and show depths.

GROUND LEVEL

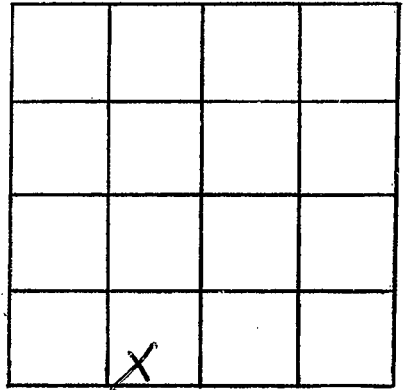

SECTION

23

Please indicate well location X.

ADDITIONAL INFORMATION

If more than one screen,
show locations of each on sketch.