

MISSISSIPPI DEPARTMENT OF NATURAL RESOURCES

Bureau of Land and Water Resources

Southport Mall

P.O. Box 10631

Jackson, Mississippi 39209

WATER WELL DRILLERS LOG

CODED

WASHITA  
#125

6-5-85 date well completed  
1985 Scholtz Drilling firm name  
WASHITA county well located

LANDOWNER:	description of formations encountered	from	to
Stauffer Chemical Hwy 615 Leland MS (mailing address)	CLAY SAND	0 18	18 100
WELL LOCATION: sec. 10 T 17 N R 2 E 3 S S Leland (distance) miles (direction) of (nearest town)			
WELL PURPOSE: <del>AGRICULTURE</del> (home, irrigation, municipal, industrial)			
WELL COMPLETION DATA:			
(1) diameter (inches) 10"			
(2) total depth (feet) 100'			
(3) static water level (feet) 29' below top of ground.			
(4) casing PVC 80 (material) (depth)			
_____ if telescope see back. (size)			
(5) screen 20 80 (length) (depth to top)			
(6) pump 10 PVC (size) (material)			
(7) pump 30 800 (HP) (yield gpm)			
(8) electric log pro (type power)			
(9) electric log no (yes or no)			
_____ X (organization running log)			
(10) how well bottom plugged cap			
DRILLERS REMARKS:			


CODED

RECEIVED  
DEC 3 - 1985

Department of Natural Resources  
Bureau of Land & Water Resources

If well telescopes please sketch and show depths.

GROUND LEVEL

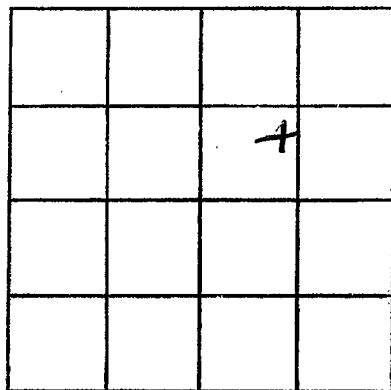

SECTION 10

Please indicate well location X.

ADDITIONAL INFORMATION

If more than one screen,  
show locations of each on sketch.

*Handwritten scribble or signature*