

MISSISSIPPI DEPARTMENT OF NATURAL RESOURCES

Bureau of Land and Water Resources

Southport Mall

P.O. Box 10631

Jackson, Mississippi 39209

WATER WELL DRILLERS LOG

CODED

WASHINGTON  
H 126

6-6-85 Schultz Drilling Washington  
date well completed firm name county well located

LANDOWNER: Bailey Peyton Hollandale MS  (mailing address)	description of formations encountered	from	to
	CLAY	0	31
	SAND	31	85
WELL LOCATION: sec. 27 T 17 N R 2 E 7 S Leland (distance) (direction) (nearest town)			
WELL PURPOSE: IRRIGATION (home, irrigation, municipal, industrial)			
WELL COMPLETION DATA:			
(1) diameter (inches) 10			
(2) total depth (feet) 85'			
(3) static water level (feet) 36' below top of ground			
(4) casing PVC 65' (material) (depth)			
(size) If telescope see back.			
(5) screen 20' 65' (length) (depth to top)			
10" PVC (size) (material)			
(6) pump 20 900 (HP) (yield gpm)			
ele (type power)			
(7) electric log no (yes or no)			
(organization running log) X			
(8) how well bottom plugged cap			
DRILLERS REMARKS:			

CODED


RECEIVED

DEC 3 1985

If well telescopes please sketch and show depths.

GROUND LEVEL

017003

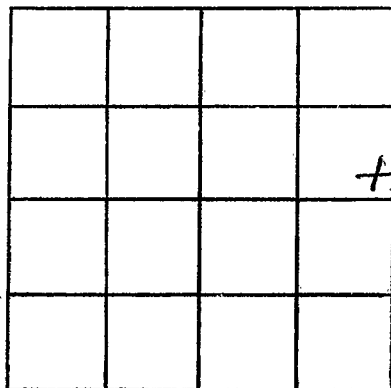

SECTION 27

Please indicate well location X.

ADDITIONAL INFORMATION

If more than one screen, show locations of each on sketch.