

MISSISSIPPI DEPARTMENT OF NATURAL RESOURCES

Bureau of Land and Water Resources

Southport Mall

P.O. Box 10631

Jackson, Mississippi 39209

WATER WELL DRILLERS LOG

CODED

WASHINGTON
H 128

Sept 27 1985 date well completed
Schultz Drilling firm name
Washington county well located

LANDOWNER:	description of formations encountered	from	to
Agua Farm Rt. 2 GREENVILLE MS (mailing address)			

WELL LOCATION:
sec. 20 T 17 N R 7 E
7 miles S-SW of Leland
(distance) (direction) (nearest town)

WELL PURPOSE: IAP
(home, irrigation, municipal, industrial)

WELL COMPLETION DATA:

- (1) diameter (inches) 8
- (2) total depth (feet) 78'
- (3) static water level (feet) 30 below top of ground. Top of house
- (4) casing PVC 58 (material) (depth)
8" (size) if telescope see back.
- (5) screen 20 (length) (depth to top)
8 (size) PVC (material)
- (6) pump 10 (HP) 500 (yield gpm)
Ecc (type power)
- (7) electric log NO (yes or no)
(organization running log)
- (8) how well bottom plugged cap


CODED

RECEIVED
DEC 3 - 1985

DRILLERS REMARKS:
Well No 34

If well telescopes please sketch and show depths.

GROUND LEVEL

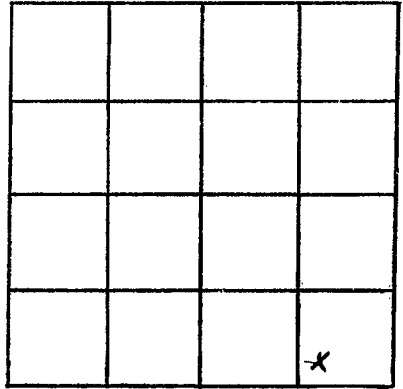

SECTION 20

Please indicate well location X.

ADDITIONAL INFORMATION

If more than one screen,
show locations of each on sketch.