

WASHINGTON  
H129

MISSISSIPPI DEPARTMENT OF NATURAL RESOURCES

Bureau of Land and Water Resources

Southport Mall

P.O. Box 10631

Jackson, Mississippi 39209

WATER WELL DRILLERS LOG

CODED

Schultz Drilling

Washington

4-11-86 19 date well completed

firm name

county well located

LANDOWNER:

AQUA FARMS

Greenville, MS

(mailing address)

description of formations encountered

from

to

CLAY 0 20  
COARSE SAND 20 60  
COARSE SAND + GRAVEL 60 80

WELL LOCATION:

sec. 30 T. 17 S. R. 7 E  
5 miles S of Greenville  
(distance) (direction) (nearest town)

WELL PURPOSE: IRRIGATION  
(home, irrigation, municipal, industrial)

WELL COMPLETION DATA:

- (1) diameter (inches) 4"
- (2) total depth (feet) 80'
- (3) static water level (feet) 28' below top of ground.
- (4) casing 4" 60'  
(material) (depth)
- (size) if telescope see back.
- (5) screen 20' 60'  
(length) (depth to top)
- 4" PVC  
(size) (material)
- (6) pump 2 50  
(HP) (yield gpm)
- elc  
(type power)
- (7) electric log NO  
(yes or no)
- X  
(organization running log)
- (8) how well bottom plugged CAP.

CODED

RECEIVED


MAY 20 1986

Department of Natural Resources  
Bureau of Land & Water Resources

DRILLERS REMARKS:

If well telescopes please sketch and show depths.

GROUND LEVEL

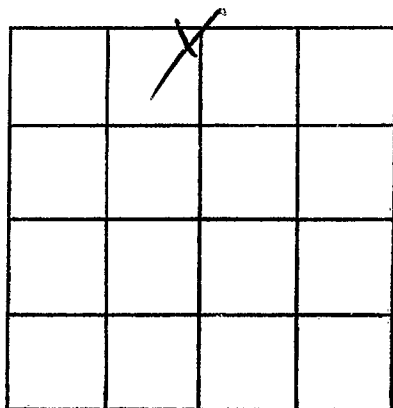

SECTION 30

Please indicate well location X.

ADDITIONAL INFORMATION

If more than one screen,  
show locations of each on sketch.