

MISSISSIPPI DEPARTMENT OF NATURAL RESOURCES

Bureau of Land and Water Resources

Southport Mall

P.O. Box 10631

Jackson, Mississippi 39209

WATER WELL DRILLERS LOG

CODED

86133DJB01
WASHINGTON
H130

5-1-86 19 date well completed

Schultz Drilling firm name

Washington county well located

LANDOWNER: AQUA FARMS
Wilmont Rd
Greenville, MS
(mailing address)

description of formations encountered

from to

CLAY SAND

0 28
28 95

WELL LOCATION:
sec. 29 T 17 N R 7 E
5 miles NW of Arcola
(distance) (direction) (nearest town)

WELL PURPOSE: IRRIGATION
(home, irrigation, municipal, industrial)

CODED

- WELL COMPLETION DATA:
- (1) diameter (inches) 10"
 - (2) total depth (feet) 95'
 - (3) static water level (feet) 38' below top of ground.
 - (4) casing PVC 65' (material) (depth)
 - (size) if telescope see back.
 - (5) screen 30' 65' (length) (depth to top)
 - 10" PVC (size) (material)
 - (6) pump 20 1000 (HP) (yield gpm)
 - (type power) el
 - (7) electric log no (yes or no)
 - K (organization running log)
 - (8) how well bottom plugged CAP

RECEIVED


MAY 20 1986

Department of Natural Resources
Bureau of Land & Water Resources

DRILLERS REMARKS:

If well telescopes please
sketch and show depths.

GROUND LEVEL

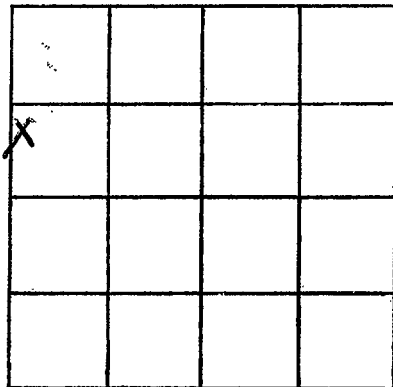

SECTION 29

Please indicate well location X.

ADDITIONAL INFORMATION

If more than one screen,
show locations of each on sketch.