

MISSISSIPPI DEPARTMENT OF NATURAL RESOURCES
Bureau of Land and Water Resources
 Southport Mall
 P.O. Box 10631
 Jackson, Mississippi 39209
WATER WELL DRILLERS LOG

CODED.

86114 KSE02
WASHINGTON
H131

4-19-86 date well completed Schultz Drilling firm name WASHINGTON county well located

LANDOWNER: Mckenzie & Belde
P.O. Box 362
ARCOLA, MS
 (mailing address)

description of formations encountered	from	to
<u>CLAY</u>	<u>0</u>	<u>24</u>
<u>COARSE SAND</u>	<u>24</u>	<u>96</u>

WELL LOCATION:
 sec 32-17 R 7E
4 miles W of ARCOLA
 (distance) (direction) (nearest town)

WELL PURPOSE: IRRIGATION
 (home, irrigation, municipal, industrial)

- WELL COMPLETION DATA:
- (1) diameter (inches) 10"
 - (2) total depth (feet) 96'
 - (3) static water level (feet) 32' below above top of ground.
 - (4) casing PVC 76'
 (material) (depth)
 - _____ if telescope see back.
 (size)
 - (5) screen 20' 76'
 (length) (depth to top)
 - 10" PVC
 (size) (material)
 - (6) pump 20 1000
 (HP) (yield gpm)
 - ele
 (type power)
 - (7) electric log no
 (yes or no)
 - x
 (organization running log)
 - (8) how well bottom plugged CAP

CODED

RECEIVED


MAY 20 1986

Department of Natural Resources
 Bureau of Land & Water Resources

DRILLERS REMARKS:

If well telescopes please sketch and show depths.

GROUND LEVEL

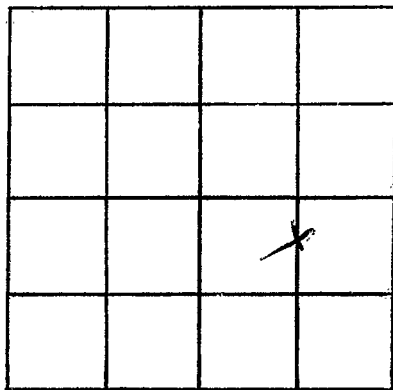

32

SECTION _____

Please indicate well location X.

ADDITIONAL INFORMATION

If more than one screen, show locations of each on sketch.