

MISSISSIPPI DEPARTMENT OF NATURAL RESOURCES

Bureau of Land and Water Resources

Southport Mall

P.O. Box 10631

Jackson, Mississippi 39209

WATER WELL DRILLERS LOG

CODED

WASHINGTON
 ✓ # 132

3-29-86
 date well completed

Schultz Drilling
 firm name

Washington
 county well located

LANDOWNER: Gene Dennis
 Rt. 1 Box 420
 Leland, MS
 (mailing address)


description of formations encountered	from	to
	CLAY	0
MED SAND	24	45
COARSE SAND	45	80

WELL LOCATION:
 sec. 10 T. 07 N. R. 7 E
 6 miles S of Leland
 (distance) (direction) (nearest town)

WELL PURPOSE: IRRIGATION
 (home, irrigation, municipal, industrial)

- WELL COMPLETION DATA:
- (1) diameter (inches) 12"
 - (2) total depth (feet) 80'
 - (3) static water level (feet) 27' below top of ground.
 - (4) casing PVC (material), (depth)
 - (size) If telescope see back.
 - (5) screen 20' 60' (length) (depth to top)
 - 12" PVC (size) (material)
 - (6) pump 40 1200 (HP) (yield gpm)
 - PTO (type power)
 - (7) electric log NO (yes or no)
 - X (organization running log)
 - (8) how well bottom plugged CAP

CODED

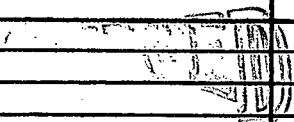


MAY 21 1986

DRILLERS REMARKS:

Department of Natural Resources
 Bureau of Land & Water Resources

If well telescopes please sketch and show depths.

GROUND LEVEL

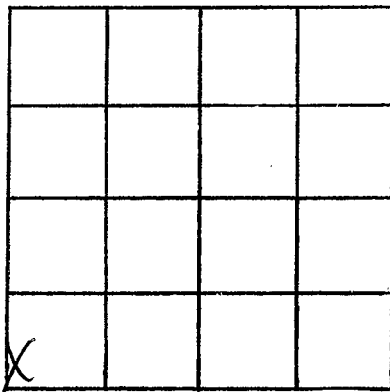

SECTION 10

Please indicate well location X.

ADDITIONAL INFORMATION

If more than one screen,
show locations of each on sketch.