

WASHINGTON
H 134

MISSISSIPPI DEPARTMENT OF NATURAL RESOURCES

Bureau of Land and Water Resources

Southport Mall

P.O. Box 10631

Jackson, Mississippi 39209

WATER WELL DRILLERS LOG

3-25-87 date well completed
Scholtz Drilling firm name
Washington county well located

LANDOWNER: AQUA FARMS Wilmont rd Greenville, MS (mailing address)	description of formations encountered	from	to
	CLAY	0	20
	Med SAND	20	40
	COARSE SAND	40	80
	CLAY	80	81
WELL LOCATION:			
sec. 19 T. 17N R. 7 E 5 miles S of Greenville (distance) (direction) (nearest town)			
WELL PURPOSE: IRRIGATION (home, irrigation, municipal, industrial)			
WELL COMPLETION DATA:			
(1) diameter (inches) 10"			
(2) total depth (feet) 80'			
(3) static water level (feet) 38' below above top of ground.			
(4) casing PVC (material), 60' (depth)			
(size) If telescope see back.			
(5) screen 20' (length), 60' (depth to top)			
10' (size), PVC (material)			
(6) pump 15 (HP), 750 (yield gpm)			
(type power) elc			
(7) electric log NO (yes or no)			
(organization running log) X			
(8) how well bottom plugged CAP			
DRILLERS REMARKS:			


RECEIVED

APR 01 1987

Department of Natural Resources
Bureau of Land & Water Resources

If well telescopes please sketch and show depths.

GROUND LEVEL

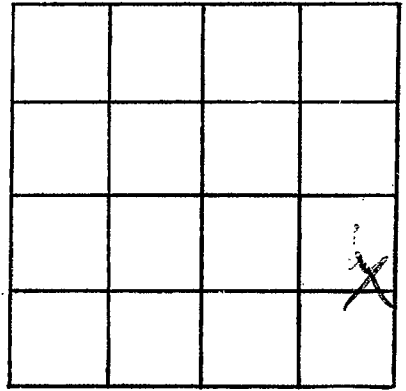

SECTION 19,

Please indicate well location X.

ADDITIONAL INFORMATION

If more than one screen,
show locations of each on sketch.