

MISSISSIPPI DEPARTMENT OF NATURAL RESOURCES

Bureau of Land and Water Resources

Southport Mall

P.O. Box 10631

Jackson, Mississippi 39209

WATER WELL DRILLERS LOG

WASHINGTON
H 135

CODED

6-11 1987 Schultz Drilling Washington
date well completed firm name county well located

LANDOWNER: AC Bulve	description of formations encountered	from	to
19 Stanton Rd. Summit, Mo. 38701 (mailing address)			
<p>WELL LOCATION:</p> <p>sec. 10 T 11 N R 7 E 3 S S (W) Leland</p> <p>(distance) miles (direction) of (nearest town)</p>	CLAY	0	27
	SAND	27	70
	SAND + Pea gravel	70	100
<p>WELL PURPOSE: IRRIGATION (home, irrigation, municipal, industrial)</p>			
<p>WELL COMPLETION DATA:</p> <p>(1) diameter (inches) 10"</p> <p>(2) total depth (feet) 100'</p> <p>(3) static water level (feet) 31' below above top of ground.</p> <p>(4) casing PVC 80' (material) (depth)</p> <p>(size) if telescope see back.</p> <p>(5) screen 20' 80' (length) (depth to top)</p> <p>10" PVC (size) (material)</p> <p>(6) pump 15 750 (HP) (yield gpm)</p> <p>ele (type power)</p> <p>(7) electric log NO (yes or no)</p> <p>X (organization running log)</p> <p>(8) how well bottom plugged CAP</p>			
<p>DRILLERS REMARKS:</p>			


RECEIVED

OCT 15 1987

Department of Natural Resources
Bureau of Land & Water Resources

If well telescopes please sketch and show depths.

GROUND LEVEL

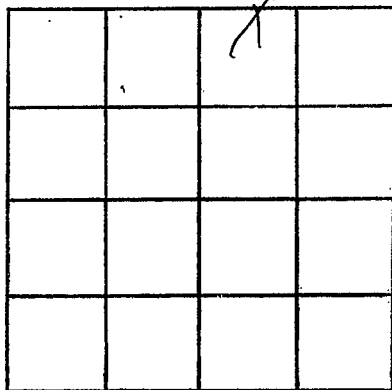

SECTION 10

Please indicate well location X.

ADDITIONAL INFORMATION

If more than one screen,
show locations of each on sketch.