

MISSISSIPPI DEPARTMENT OF NATURAL RESOURCES

Bureau of Land and Water Resources

Southport Mall

P.O. Box 10631

Jackson, Mississippi 39209

WATER WELL DRILLERS LOG

WASHINGTON
H/36
0193

CODED

7-10 1987 Schultz Drilling Washington
date well completed firm name county well located

LANDOWNER: AQUA FARMS
Wilmot Rd
Greenville MS
(mailing address)

description of formations encountered	from	to
CLAY	0	27
Med. SAND	27	50
COARSE SAND	50	100

WELL LOCATION:
sec. 29 T. 17 N. R. 7 E. S. 5
5 miles S of Greenville
(distance) (direction) (nearest town)

WELL PURPOSE: IRRIGATION
(home, irrigation, municipal, industrial)

- WELL COMPLETION DATA:
- (1) diameter (inches) 10"
 - (2) total depth (feet) 100'
 - (3) static water level (feet) 44' below top of ground.
 - (4) casing PVC 80 (material) (depth)
 - (size) if telescope see back.
 - (5) screen 20' 80' (length) (depth to top)
 - 10" PVC (size) (material)
 - (6) pump 20 1000 (HP) (yield gpm)
 - ele (type power)
 - (7) electric log NO (yes or no)
 - X (organization running log)
 - (8) how well bottom plugged CAP

RECEIVED


OCT 05 1987

Department of Natural Resources
Bureau of Land & Water Resources

DRILLERS REMARKS:

If well telescopes please sketch and show depths.

GROUND LEVEL

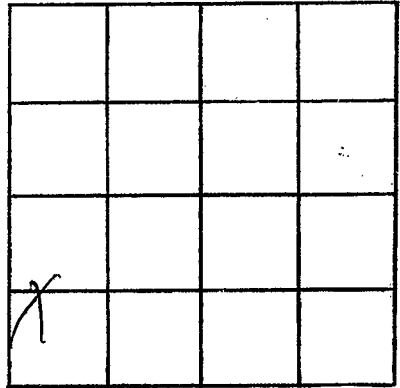

SECTION

29

Please indicate well location X.

ADDITIONAL INFORMATION

If more than one screen,
show locations of each on sketch.