

MISSISSIPPI DEPARTMENT OF NATURAL RESOURCES

Bureau of Land and Water Resources

Southport Mall

P.O. Box 10631

Jackson, Mississippi 39209

WATER WELL DRILLERS LOG

WRR-1000
H 137
146 C

Coded

Schultz Drilling

Washington

8-19-87
 date well completed

firm name

county well located

LANDOWNER: <u>Fred Ballard</u> <u>PT. 1</u>	description of formations encountered	from	to
<u>Seland ms. 38756</u> (mailing address)	<u>CLAY SAND</u>	<u>0</u> <u>40</u>	<u>40</u> <u>97</u>
<p>WELL LOCATION:</p> <p>sec. <u>32</u> T. <u>17</u> N. R. <u>7</u> E. <u>3</u> miles <u>W</u> of <u>Arcola</u> (distance) (direction) (nearest town)</p>			
<p>WELL PURPOSE: <u>irrigation</u> (home, irrigation, municipal, industrial)</p>			
<p>WELL COMPLETION DATA:</p>			
<p>(1) diameter (inches) <u>16"</u> (2) total depth (feet) <u>97'</u> (3) static water level (feet) <u>33'</u> below/above top of ground. (4) casing <u>PVC</u>, <u>77'</u> (material), (depth)</p>			
<p>_____ if telescope see back. (size) (5) screen <u>20'</u>, <u>77'</u> (length), (depth to top) <u>16</u>, <u>steel</u> (size), (material)</p>			
<p>(6) pump <u>40</u>, <u>1200</u> (HP), (yield gpm) <u>ele</u> (type power)</p>			
<p>(7) electric log <u>NO</u> (yes or no) <u>X</u> (organization running log)</p>			
<p>(8) how well bottom plugged <u>CAP</u></p>			

RECEIVED


OCT 29 1987

Department of Natural Resources
 Bureau of Land & Water Resources

DRILLERS REMARKS:

If well telescopes please sketch and show depths.

GROUND LEVEL

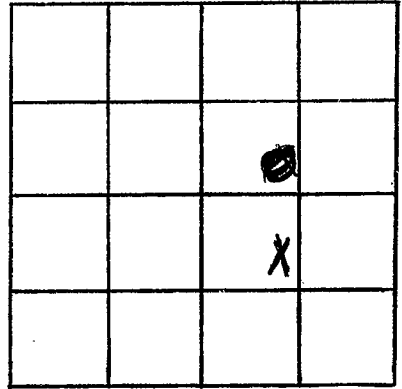

SECTION

32

Please indicate well location X.

ADDITIONAL INFORMATION

If more than one screen,
show locations of each on sketch.