

MISSISSIPPI DEPARTMENT OF NATURAL RESOURCES

Bureau of Land and Water Resources

Southport Mall

P.O. Box 10631

Jackson, Mississippi 39209

WATER WELL DRILLERS LOG

Washington
H 138
146 C
9-3-87

Called

Scholtz Drilling

Washington

date well completed

firm name

county well located

LANDOWNER: FRED BALLARD

Rt. 1

Leland, MS 38756

(mailing address)

description of formations encountered

from

to

CLAY	0	40
SAND	40	90
SAND + GRAVEL	90	120

WELL LOCATION:

sec 32 T 17 N R 7 E
3 miles W of ARCOLA
 (distance) (direction) (nearest town)

WELL PURPOSE: IRRIGATION
 (home, irrigation, municipal, industrial)

WELL COMPLETION DATA:

- (1) diameter (inches) 16"
- (2) total depth (feet) 120'
- (3) static water level (feet) 33 below above top of ground.
- (4) casing PVC 80'
 (material) (depth)
- _____ if telescope see back.
 (size)
- (5) screen 40' 80'
16" (length) (depth to top)
steel
 (size) (material)
- (6) pump 50 2500
 (HP) (yield gpm)
ele
 (type power)
- (7) electric log NO
 (yes or no)
X
 (organization running log)
- (8) how well bottom plugged CAP

RECEIVED


SEP 20 1987

Department of Natural Resources
 Bureau of Land & Water

DRILLERS REMARKS:

If well telescopes please sketch and show depths.

GROUND LEVEL

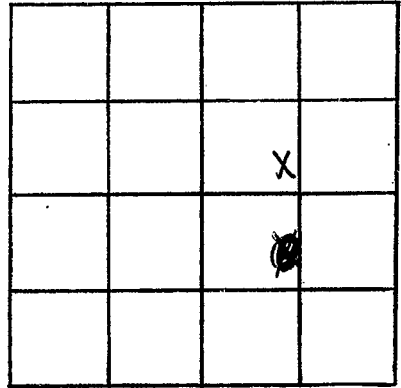

SECTION 32

Please indicate well location X.

ADDITIONAL INFORMATION

If more than one screen,
show locations of each on sketch.