

MISSISSIPPI DEPARTMENT OF NATURAL RESOURCES

Bureau of Land and Water Resources

Southport Mall

P.O. Box 10631

Jackson, Mississippi 39209

WATER WELL DRILLERS LOG

WASHINGTON  
H 141

CODED

4-27 1988 Schultz Drilling Washington  
date well completed firm name county well located

LANDOWNER: AQUA FARMS	description of formations encountered	from	to
Pt. 2 Box 620	CLAY	0	20
Greenhill Dr. 38701	MEDIUM SAND	20	50
(mailing address)	COARSE SAND	50	92
<b>WELL LOCATION:</b>			
sec. 31 T 17 N R 7 E			
2 miles E of WAYSIDE			
(distance) (direction) (nearest town)			
<b>WELL PURPOSE:</b> IRRIGATION			
(home, irrigation, municipal, industrial)			
<b>WELL COMPLETION DATA:</b>			
(1) diameter (inches) 10"			
(2) total depth (feet) 92'			
(3) static water level (feet) 36' -below top of ground.			
(4) casing PVC 72' (material) (depth)			
(size) If telescope see back			
(5) screen 20' 72' (length) (depth to top)			
10" PVC (size) (material)			
(6) pump 20 1000 (HP) (yield gpm)			
ele (type power)			
(7) electric log NO (yes or no)			
(organization running log) X			
(8) how well bottom plugged CAP			
<b>DRILLERS REMARKS:</b>			


RECEIVED

JUN 16 1988

Department of Natural Resources  
Bureau of Land & Water Resources

If well telescopes please sketch and show depths.

GROUND LEVEL

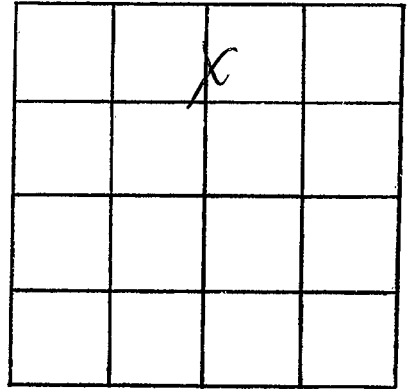

SECTION

31

Please indicate well location X.

ADDITIONAL INFORMATION

If more than one screen,  
show locations of each on sketch.