

MISSISSIPPI DEPARTMENT OF NATURAL RESOURCES

Bureau of Land and Water Resources

Southport Mall

P.O. Box 10631

Jackson, Mississippi 39209

WATER WELL DRILLERS LOG

WASHINGTON
H142

CODED

4-30-88 date well completed Schultz Drilling firm name Washington county well located

LANDOWNER: ADDA FARMS
Rt. 2, Box 620
Greenville, MS
(mailing address)

description of formations encountered	from	to
CLAY	0	20
Medium SAND	20	44
COARSE SAND	44	80
COARSE SAND, peagrand	80	97

WELL LOCATION:
sec. 31 T 17 S R 1 E
2 miles E of WAYSIDE
(distance) (direction) (nearest town)

WELL PURPOSE: IRRIGATION
(home, irrigation, municipal, industrial)

- WELL COMPLETION DATA:
- (1) diameter (inches) 10"
 - (2) total depth (feet) 97'
 - (3) static water level (feet) 36' below above top of ground.
 - (4) casing PVC, 77'
(material) (depth)
 - (size) if telescope see back.
 - (5) screen 20', 77'
(length) (depth to top)
 - 10", PVC
(size) (material)
 - (6) pump 20, 1000
(HP) (yield gpm)
 - ele
(type power)
 - (7) electric log NO
(yes or no)
 - X
(organization running log)
 - (8) how well bottom plugged CAP

RECEIVED

JUN 16 1988


Department of Natural Resources
Bureau of Land & Water Resources

DRILLERS REMARKS:

If well telescopes please sketch and show depths.

117
11000

GROUND LEVEL

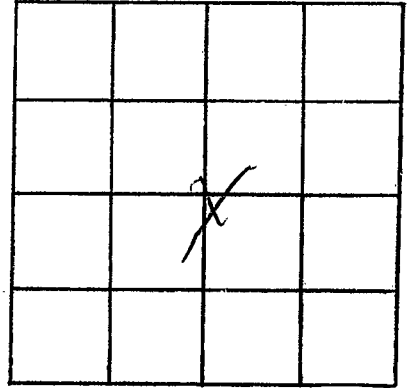

SECTION 31

Please indicate well location X.

ADDITIONAL INFORMATION

If more than one screen,
show locations of each on sketch.