

MISSISSIPPI DEPARTMENT OF NATURAL RESOURCES

Bureau of Land and Water Resources

Southport Mall

P.O. Box 10631

Jackson, Mississippi 39209

WATER WELL DRILLERS LOG

Washington  
H 143

CODED

5-15 1988 date well completed      Scholtz Drilling firm name      Washington county well located

LANDOWNER: THAD Potter  
Box 2647  
Natchez ms 38780  
(mailing address)

description of formations encountered	from	to
CLAY	0	20
SAND	20	60
SAND + pea gravel	60	80

WELL LOCATION:  
sec. 33 T 17 N R 7 E  
2 miles W of Natchez  
(distance) (direction) (nearest town)

WELL PURPOSE: IRRIGATION  
(home, irrigation, municipal, industrial)

- WELL COMPLETION DATA:
- (1) diameter (inches) 8"
  - (2) total depth (feet) 84'
  - (3) static water level (feet) 32' below top of ground.
  - (4) casing PVC 64' (material) (depth)
  - (5) screen 20' 64' (length) (depth to top)  
8" PVC (size) (material)
  - (6) pump 15 750' (HP) (yield gpm)  
elb (type power)
  - (7) electric log NO (yes or no)  
X (organization running log)
  - (8) how well bottom plugged CAP

RECEIVED


JUN 18 1988

Department of Natural Resources  
Bureau of Land & Water Resources

DRILLERS REMARKS:

If well telescopes please  
sketch and show depths.

GROUND LEVEL

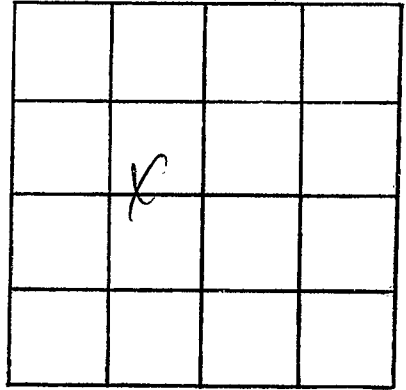

SECTION 33

Please indicate well location X.

ADDITIONAL INFORMATION

If more than one screen,  
show locations of each on sketch.