

MISSISSIPPI DEPARTMENT OF NATURAL RESOURCES

Bureau of Land and Water Resources

P.O. Box 10631

Jackson, Mississippi 39209

WATER WELL DRILLERS LOG

COUNTY WELL LOCATED <i>Wash</i>	
WELL NUMBER <i>H 150</i>	CODED
DATE WELL COMPLETED <i>20 oct 90</i>	

PERMIT NUMBER
NAME OF DRILLING FIRM <i>Lambert Drilling</i>

NAME & MAILING ADDRESS OF LANDOWNER <i>L. Grice</i>			
<i>Wagside, miss</i>			
WELL LOCATION: SEC	TOWNSHIP	RANGE	
<i>34</i>	<i>17</i>	<i>7</i>	
DISTANCE	DIRECTION	NEAREST TOWN	
<i>4</i> Miles	<i>E</i>	of <i>Wagside</i>	
OTHER LANDMARK			
WELL PURPOSE: Home, Irrigation, Municipal, Industrial, Fish Pond, etc. <i>homes</i>			

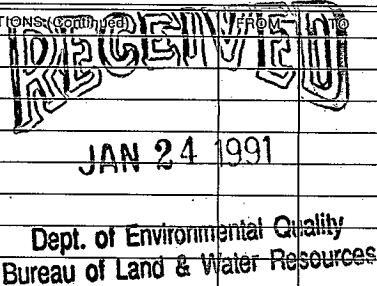
PUMP DATA			
PUMP TYPE (Circle One): <u>Submersible</u> Turbine, Jet Flowing Well, Other (Describe) _____			
POWER TYPE (Circle One): <u>Electric</u> , Tractor, Diesel, Gasoline, Butane, Other (Describe) _____ H/P <u>3</u>			
Pump Capacity (GPM)	No. of Stages	Setting Depth	
<i>50</i>	<i>9</i>	<i>105</i> FT.	
PUMP TEST			
Well yielded _____ GPM with a drawdown of _____ ft. after _____ hours of pumping			

WELL DATA		
Well Depth <i>410</i>	Casing Diameter (In.) <i>4x2</i>	Casing Length (Ft.) <i>370</i>
Type of Casing <i>PVC</i>	Hole Depth <i>410</i>	Depth to Static Water Level <i>36</i>
TYPE OF COMPLETION: (Circle One or More): Gravel Packed, Underreamed, <u>Telescoped</u> , Natural Development, Open Hole, Other _____		
Top of Lap Pipe or Reduction in Casing		
FEET		IF TELESCOPED OR MORE THAN ONE SCREEN: USE BACK PAGE

LOG DATA	
TYPE OF LOG RUN (Circle One): <u>No Log Run</u> , Electric, Gamma Ray, Density, Sonic, Neutron, Other (Describe) _____	
Name of Organization Running Log	

SCREEN DATA		
Diameter - Inches <i>2"</i>	Length - Feet <i>40</i>	Slot Size - Inches <i>10</i>
Screen Type <i>PVC</i>	Depth to Bottom - Feet <i>410-370</i>	

GEOLOGIC DATA (Office Use Only)			
Surface Elev.	Geologic Unit	Unit Thickness	Depth to Top
Subs. SWL	Date	Analysis	Aquifer Test
Driller's Remarks			

DESCRIPTION OF FORMATIONS ENCOUNTERED	FROM	TO	FORMATIONS (continued)
<i>Clay</i>	<i>0</i>	<i>25</i>	
<i>Sand</i>	<i>25</i>	<i>55</i>	
<i>Red gravel</i>	<i>55</i>	<i>85</i>	
<i>Clay</i>	<i>85</i>	<i>142</i>	
<i>Clay & sand</i>	<i>142</i>	<i>355</i>	
<i>Sand</i>	<i>355</i>	<i>410</i>	

IF MORE SPACE IS NEEDED, USE BACK

If well telescopes please sketch and show depths.

GROUND LEVEL

160 4

370 2¹¹

410 2¹¹ 500

		X	

SECTION 31

Please indicate well location X.

ADDITIONAL INFORMATION

If more than one screen,
show location of each on sketch.