

MISSISSIPPI DEPARTMENT OF NATURAL RESOURCES

Bureau of Land and Water Resources

COUNTY WELL LOCATED <i>Wash</i>	
WELL NUMBER <i>H 156</i>	CODED <input checked="" type="checkbox"/>
DATE WELL COMPLETED <i>14 Mar 92</i>	

PERMIT NUMBER <i>146c</i>
NAME OF DRILLING FIRM <i>Lambert Drilling</i>

P.O. Box 10631
Jackson, Mississippi 39209
WATER WELL DRILLERS LOG

NAME & MAILING ADDRESS OF LANDOWNER <i>David Higgs Wayside MS.</i>			
WELL LOCATION:	SEC <i>31</i>	TOWNSHIP <i>17 N</i>	RANGE <i>7 E</i>
DISTANCE <i>14</i> Miles	DIRECTION <i>SE</i>	NEAREST TOWN <i>Greenville</i>	
OTHER LANDMARK			
WELL PURPOSE: Home, Irrigation, Municipal, Industrial, Fish Pond, etc. <i>home</i>			

PUMP DATA		
PUMP TYPE (Circle One): <input checked="" type="radio"/> Submersible, <input type="radio"/> Turbine, <input type="radio"/> Jet <input type="radio"/> Flowing Well, Other (Describe) _____		
POWER TYPE (Circle One): <input checked="" type="radio"/> Electric, <input type="radio"/> Tractor, <input type="radio"/> Diesel, <input type="radio"/> Gasoline, <input type="radio"/> Butane, Other (Describe) _____ H/P _____		
Pump Capacity (GPM) <i>20</i>	No. of Stages <i>9</i>	Setting Depth <i>105</i> FT.
PUMP TEST		
Well yielded _____ GPM with a drawdown of _____ ft. after _____ hours of pumping		

WELL DATA		
Well Depth <i>520</i>	Casing Diameter (In.) <i>4x2</i>	Casing Length (Ft.) <i>500</i>
Type of Casing <i>PVC</i>	Hole Depth <i>520</i>	Depth to Static Water Level <i>41</i>
TYPE OF COMPLETION: (Circle One or More): <input checked="" type="checkbox"/> Gravel Packed, <input type="checkbox"/> Underreamed, <input type="checkbox"/> Telescoped, <input checked="" type="checkbox"/> Natural Development, <input type="checkbox"/> Open Hole, <input type="checkbox"/> Other _____		
Top of Lap Pipe or Reduction in Casing		
FEET	IF TELESCOPED OR MORE THAN ONE SCREEN: USE BACK PAGE	

LOG DATA	
TYPE OF LOG RUN (Circle One): <input type="radio"/> No Log Run, <input type="radio"/> Electric, <input type="radio"/> Gamma Ray, <input type="radio"/> Density, <input type="radio"/> Sonic, <input type="radio"/> Neutron, Other (Describe) _____	
Name of Organization Running Log	

SCREEN DATA		
Diameter - Inches <i>2"</i>	Length - Feet <i>20'</i>	Slot Size - Inches <i>10</i>
Screen Type <i>PVC</i>	Depth to Bottom - Feet <i>520-500</i>	

GEOLOGIC DATA (Office Use Only)			
Surface Elev.	Geologic Unit	Unit Thickness	Depth to Top
Subs. SWL	Date	Analysis	Aquifer Test
Driller's Remarks			

DESCRIPTION OF FORMATIONS ENCOUNTERED	FROM	TO	FORMATIONS (Continued)
<i>Clay</i>	<i>0</i>	<i>24</i>	<div style="font-size: 2em; font-weight: bold; border: 2px solid black; padding: 5px; display: inline-block;">RECEIVED</div> <div style="font-size: 1.5em;">APR 23 1992</div> <div style="font-weight: bold;">Dept. of Environmental Quality Bureau of Land & Water Resources</div>
<i>Sand</i>	<i>24</i>	<i>60</i>	
<i>Gravel</i>	<i>60</i>	<i>88</i>	
<i>Clay</i>	<i>88</i>	<i>280</i>	
<i>Clayst sand</i>	<i>280</i>	<i>440</i>	
<i>Sand</i>	<i>440</i>	<i>520</i>	

IF MORE SPACE IS NEEDED, USE BACK

If well telescopes please sketch and show depths.


GROUND LEVEL

140 4''

500 2''

520 2'' screen

If more than one screen, show location of each on sketch.

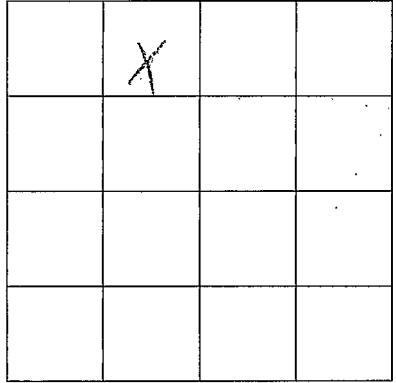

SECTION 31

Please indicate well location X.

ADDITIONAL INFORMATION

Handwritten notes:
1/2" screen
1/2" screen