

MISSISSIPPI DEPARTMENT OF ENVIRONMENTAL QUALITY

Office of Land and Water Resources

P. O. Box 10631  
Jackson, MS 39289-0631

WATER WELL DRILLERS LOG

COUNTY WELL LOCATED  
Washington

WELL NUMBER  
H102

DATE WELL COMPLETED  
12-29-99

PERMIT NUMBER  
GW39322

NAME OF DRILLING FIRM  
Schudeo Ltd

NAME & MAILING ADDRESS OF LANDOWNER  
Agua Farms  
Greenville MS  
38701

WELL LOCATION: SEC 29 TOWNSHIP 17 RANGE 7

DISTANCE 4 1/2 Miles DIRECTION NW of NEAREST TOWN Arcola

OTHER LANDMARK

WELL PURPOSE: Home, Irrigation, Municipal, Industrial, Fish Pond etc.

PUMP DATA

PUMP TYPE (Circle One):  
Submersible, Turbine, Jet, Flowing Well,  
Other (Describe)

POWER TYPE (Circle One):  
Electric, Tractor, Diesel, Gasoline, Butane,  
Other (Describe) H/P

Pump Capacity (GPM) No. of Stages Setting Depth FT.

PUMP TEST

Well yielded \_\_\_\_\_ GPM with  
a drawdown of \_\_\_\_\_ ft.  
after \_\_\_\_\_ hours of pumping

WELL DATA

Well Depth 85 Casing Diameter (In.) 10 Casing Length (Ft.) 65

Type of Casing pvc Hole Depth 85 Depth to Static Water Level

LOG DATA

TYPE OF LOG RUN (Circle One): No Log Run,  
Electric, Gamma Ray, Density, Sonic, Neutron,  
Other (Describe)

Name of Organization Running Log

TYPE OF COMPLETION: (Circle One or More):  
Gravel Packed, Underreamed, Telescoped,  
Natural Development, Open Hole, Other  
(Describe)

WELL GROUTED TO A DEPTH OF \_\_\_\_\_ FEET  
Type Grout (circle one): Cement, Bentonite, or Mix

GEOLOGIC DATA (Office Use Only)

Surface Elev.	Geologic Unit	Unit Thickness	Depth to Top
Subs. SWL	Date	Analysis	Aquifer Test

SCREEN DATA

Diameter - Inches 10 Length - Feet 20 Slot Size - Inches 1032

Screen Type pvc Depth to Bottom - Feet 85

Driller's Remarks

Top of Lap Pipe or Reduction in Casing

IF TELESCOPED OR MORE THAN ONE SCREEN, USE BACK PAGE

DESCRIPTION OF FORMATIONS ENCOUNTERED	FROM	TO
<u>Gumbo</u>	<u>6</u>	<u>23</u>
<u>med. sand</u>	<u>23</u>	<u>50</u>
<u>med to coarse sand</u>	<u>50</u>	<u>85</u>
<u>little p-gravel</u>		
<u>clay</u>	<u>85</u>	

FORMATIONS (Continued)

DEPT OF ENVIRONMENTAL QUALITY


MAR 28 2000

Dept. of Environmental Quality  
Office of Land & Water Resources

IF MORE SPACE IS NEEDED, USE BACK

If well telescopes please  
sketch and show depths.

GROUND LEVEL

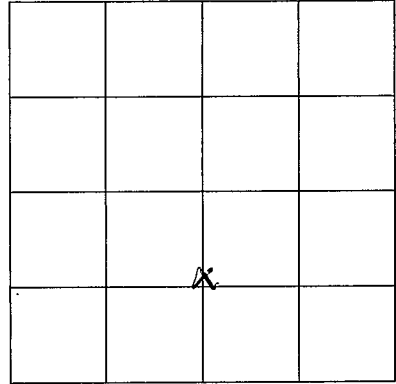

SECTION 29

Please indicate well location X.

ADDITIONAL INFORMATION

If more than one screen,  
show location of each on sketch.