

# Edna Plantation

## MISSISSIPPI DEPARTMENT OF ENVIRONMENTAL QUALITY

Office of Land and Water Resources

P. O. Box 10631  
Jackson, MS 39289-0631  
WATER WELL DRILLERS LOG

COUNTY WELL LOCATED <b>Washington</b>	
WELL NUMBER <b>H-177</b>	CODED
DATE WELL COMPLETED <b>6-3-02</b>	

PERMIT NUMBER <b>MSAW-39275</b>
NAME OF DRILLING FIRM <b>Chicot Irrigation</b>

NAME & MAILING ADDRESS OF LANDOWNER <b>EDNA PLANTATION</b> <b>1704 WALKER LANE, SUITE 5</b> <b>GREENVILLE, MS. 38901</b>			
Latitude: <b>33 17 31</b> Longitude: <b>090 53 62</b>			
WELL LOCATION	SEC	TOWNSHIP	RANGE
	<b>26</b>	<b>17 N</b>	<b>7 W</b>
DISTANCE	DIRECTION	NEAREST TOWN	
<b>2.4</b> Miles	<b>South</b>	of <b>Wilmont</b>	
OTHER LANDMARK			
WELL PURPOSE: Home <input checked="" type="checkbox"/> Irrigation Municipal, Industrial, Fish Pond, etc.			

PUMP DATA		
PUMP TYPE (Circle One): Submersible, <input checked="" type="checkbox"/> Turbine, Jet, Flowing Well, Other (Describe) _____		
POWER TYPE (Circle One): Electric, Tractor, <input checked="" type="checkbox"/> Diesel, Gasoline, Butane, Other (Describe) _____ H/P <b>40</b>		
DESCRIPTION OF FORMATIONS ENCOUNTERED	FROM	TO
<b>Top Soil</b>	<b>0</b>	<b>10</b>
<b>Mix Clay - Sand</b>	<b>10</b>	<b>40</b>
<b>Fine Sand</b>	<b>40</b>	<b>75</b>
<b>Med Coarse Sand</b>	<b>75</b>	<b>85</b>
<b>Fine Sand</b>	<b>85</b>	<b>90</b>
<b>Coarse Sand</b>	<b>90</b>	<b>110</b>
<b>Gravel - Sand</b>	<b>110</b>	<b>113</b>
<b>RECEIVED</b>		
<b>JUN 10 2002</b>		
Dept. of Environmental Quality Office of Land & Water Resources		
Top of Lap Pipe or Reduction in Casing		
FEET	IF TELESCOPED OR MORE THAN ONE SCREEN: USE BACK PAGE	


WELL DATA		
Well Depth <b>110</b>	Casing Diameter (In.) <b>16</b>	Casing Length (Ft.) <b>80</b>
Type of Casing <b>PVC</b>	Hole Depth <b>113</b>	Depth to Static Water Level
TYPE OF COMPLETION: (Circle One or More): <input checked="" type="checkbox"/> Gravel Packed, Underreamed, Telescoped, <input type="checkbox"/> Natural Development, <input type="checkbox"/> Open Hole, <input type="checkbox"/> Other (Describe) _____		
WELL GROUTED TO A DEPTH OF _____ FEET Type Grout (circle one): Cement, Bentonite, or Mix		

SCREEN DATA		
Diameter - Inches <b>16</b>	Length - Feet <b>30</b>	Slot Size - Inches <b>651</b>
Screen Type <b>PVC</b>	Depth to Bottom - Feet <b>110</b>	

I certify that the well was drilled, constructed and completed in accordance with all applicable Requirements of the Mississippi Department of Environmental Quality and/or the Mississippi Department of Health regulations and state laws.

**James D. McMill** 6/05/02  
Signature of Licensed Driller and License No. \_\_\_\_\_ Date \_\_\_\_\_

If well telescopes please sketch and show depths.

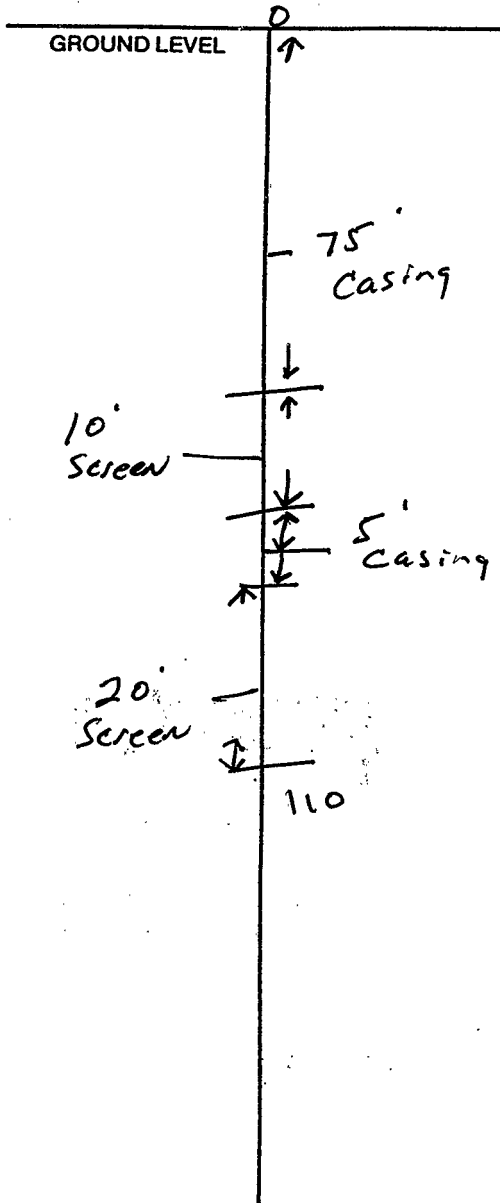

If more than one screen, show location of each on sketch.

	+		

SECTION 26

Please indicate well location X.

Pump Capacity (GPM)	No. of Stages	Setting Depth	FT.
PUMP TEST			
Well yielded _____ GPM with a drawdown of _____ ft. after _____ hours of pumping			

LOG DATA

TYPE OF LOG RUN (Circle One): No Log Run  
 Electric, Gamma Ray, Density, Sonic, Neutron, Other (Describe) \_\_\_\_\_

Name of Organization Running Log \_\_\_\_\_

GEOLOGIC DATA (Office Use Only)

Surface Elev.	Geologic Unit	Unit Thickness	Depth to Top
Subs. SWL	Date	Analysis	Aquifer Test

Driller's Remarks

\_\_\_\_\_

\_\_\_\_\_

