

Edna Plantation #2
(12")

MISSISSIPPI DEPARTMENT OF ENVIRONMENTAL QUALITY

Office of Land and Water Resources

P. O. Box 10631
Jackson, MS 39289-0631
WATER WELL DRILLERS LOG

COUNTY WELL LOCATED
Washington

WELL NUMBER
H-178

CODED

DATE WELL COMPLETED
6-3-02

PERMIT NUMBER
MSGW-39274

NAME OF DRILLING FIRM
Chicot Irrigation

NAME & MAILING ADDRESS OF LANDOWNER
**EDNA PLANTATION
C/O CAPITOL AG
1704 WALKER LANE SUITES**

Latitude: **33 17 47**
Longitude: **090 53 94**

WELL LOCATION: SEC **26** TOWNSHIP **17** RANGE **7**

DISTANCE **2** Miles **West** of **Wilmont**

OTHER LANDMARK

WELL PURPOSE: Home Irrigation, Municipal, Industrial, Fish Pond, etc.

PUMP DATA

PUMP TYPE (Circle One):
Submersible, Turbine, Jet, Flowing Well,
Other (Describe)

POWER TYPE (Circle One):
Electric, Tractor, Diesel, Gasoline, Butane,
Other (Describe) H/P **40**

DESCRIPTION OF FORMATIONS ENCOUNTERED	FROM	TO
Top Soil	0	10
Mix Clay Sand	10	40
Fine Sand	40	50
Coarse Sand	50	65
Fine Sand	65	80
Coarse Sand	80	100
Fine Sand	100	108

RECEIVED
JUN 10 2002

Dept. of Environmental Quality
Office of Land and Water Resources

FEET IF TELESCOPED OR MORE THAN ONE SCREEN: USE BACK PAGE

WELL DATA

Well Depth 105	Casing Diameter (In.) 16	Casing Length (Ft.) 75
Type of Casing PVC	Hole Depth 108	Depth to Static Water Level

TYPE OF COMPLETION: (Circle One or More):
Gravel Packed, Underreamed, Telescoped,
Natural Development, Open Hole, Other
(Describe)

WELL GROUTED TO A DEPTH OF _____ FEET
Type Grout (circle one): Cement, Bentonite, or Mix

SCREEN DATA


Diameter - Inches 16	Length - Feet 35	Slot Size - Inches .051
Screen Type PVC	Depth to Bottom - Feet 110	

I certify that the well was drilled, constructed and completed in accordance with all applicable Requirements of the Mississippi Department of Environmental Quality and/or the Mississippi Department of Health regulations and state laws.

James D. McDonald 6/05/02
Signature of Licensed Driller and License No. Date

Additional Information Required On Back

If well telescopes please sketch and show depths.

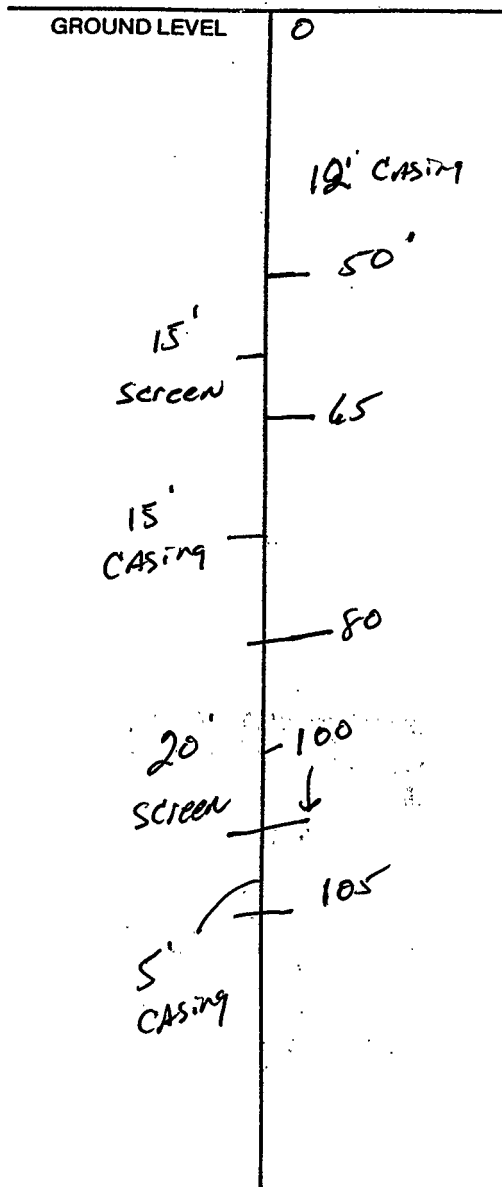

If more than one screen, show location of each on sketch.

	X		

SECTION 26

Please indicate well location X.

Pump Capacity (GPM)	No. of Stages	Setting Depth	FT.
PUMP TEST			
Well yielded _____ GPM with a drawdown of _____ ft. after _____ hours of pumping			

LOG DATA

TYPE OF LOG RUN (Circle One):	No Log Run
Electric, Gamma Ray, Density, Sonic, Neutron, Other (Describe)	_____
Name of Organization Running Log	

GEOLOGIC DATA (Office Use Only)

Surface Elev.	Geologic Unit	Unit Thickness	Depth to Top
Subs. SWL	Date	Analysis	Aquifer Test

Driller's Remarks
