


If well telescopes please sketch and show depths.

GROUND LEVEL

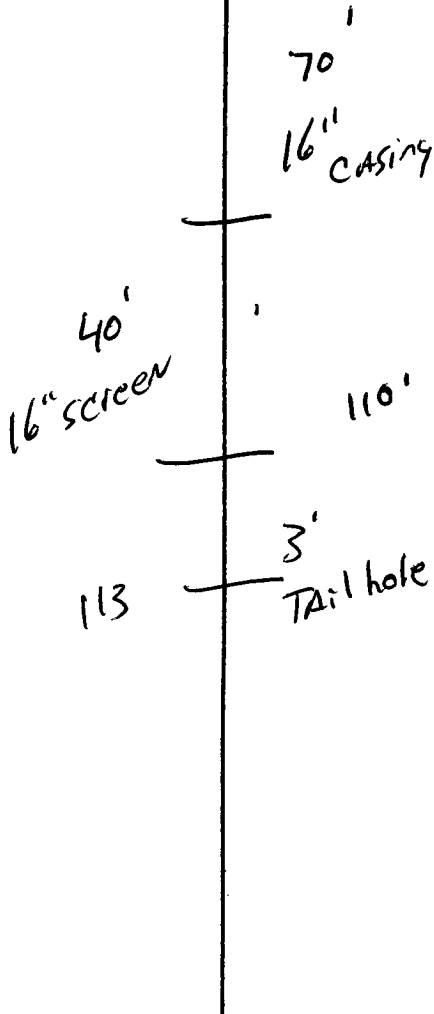

		*	

SECTION 34

Please indicate well location X.

Pump Capacity (GPM)	No. of Stages	Setting Depth
<u>3000</u>	<u>1</u>	<u>60</u> FT.
PUMP TEST		
Well yielded <u>3000</u> GPM with a drawdown of <u>15</u> ft. after <u>2</u> hours of pumping		

LOG DATA

TYPE OF LOG RUN (Circle One): Me Log Run, Electric, Gamma Ray, Density, Sonic, ~~Neutron~~, Other (Describe) _____

Name of Organization Running Log _____

GEOLOGIC DATA (Office Use Only)

Surface Elev.	Geologic Unit	Unit Thickness	Depth to Top
Subs. SWL	Date	Analysis	Aquifer Test

Driller's Remarks

Very Good well Formation

If more than one screen, show location of each on sketch.