<b>4</b>	State W	ell Report	For Office Use Only:	
<sub>County:</sub> Washington	Part 1		For Office Use Only:	
Permit #: 60 41055	Mississippi Department of Environmental Quality		Aquifer:	
Irrigation Equipment	Office of Land and Water Resources P.O. Box 10631		Well #: <u>H- 201</u>	
		S 39289-0631	L. S. Elevation:	
Date drilling completed: $5-8-06$	(001)5	061-5210		
(601)35		-6938 (fax)	E-log #:	
State Law requires that this rep		driller in detail and filed w	ith the Department with	
30 days of completion of drilling Well Owner Informa		Wal	Location	
Owner NameIsola Planta	Latitude: 33 18 21.		Longitude:	
Mailing Address: <u>Rt.1, Box 34</u>	19	Method of Lat/Long (circle one): Conventional Survey,		
		A LISGS quad, Hand-held	GPS, Survey-grade GPS	
		$X = \frac{50}{4} \times \frac{21}{100} \times \frac{17}{100} \times \frac$		
Leland, MS City Sta	38756			
City Sta	te Zip Code	Distance Direction Nearest Town		
Telephone No. ()		6 Miles NW	of <u>Arcola</u>	
	Well D		~	
Purpose of Well (circle one) Home Ind Date well drilling started: $5 - 8 - 0.6$	Date w		Otter 8-06	
If flowing method of flow mendation V-				
it nowing, memor of now regulation. Va	lve Other (de	escribe)		
-	<u> </u>			
Static Water Level: 24' feet at	bove of below (circle one) la	and surface Date measured:	5-9-06	
Static Water Level: <u>24</u> feet at Method of Measurement (circle one)	bove of below (circle one) la	and surface Date measured: air line other:	5-9-06	
Static Water Level: 24' feet at	bove of below (circle one) la feel tape electric tape 7.6 l	and surface Date measured: air line other:	5-9-06	
Static Water Level: <u>24</u> feet at Method of Measurement (circle one)	bove of below (circle one) la	and surface Date measured: air line other:	5-9-06	
Static Water Level: $24'$ feet at Method of Measurement (circle one) (s Hole depth: $76$ Well dep Type of grout (circle one): Cement	bove of below (circle one) la feel tape electric tape pth: 76'	and surface Date measured: air line other:	5-9-06 10 <u>feet</u>	
Static Water Level: $24'$ feet at Method of Measurement (circle one) (s Hole depth: $76$ Well dep Type of grout (circle one): Cement	bove of below (circle one) la reel tape electric tape pth:76 ' Bentonite Mix ng diameter:10	and surface Date measured: air line other: Well grouted to a depth of	5-9-06 10 feet VC 160	
Static Water Level: <u>24</u> feet at Method of Measurement (circle one) (s Hole depth: <u>76</u> Well depth Type of grout (circle one): Cement Casing length: <u>46</u> feet Casin	bove of below (circle one) la teel tape electric tape pth:76 ' Bentonite Mix ng diameter:10 cen diameter:10	and surface Date measured: air line other: Well grouted to a depth of inches Type of casing: P inches Type of screen: P	5-9-06 10 feet VC 160 VC 160	
Static Water Level: <u>24</u> feet at Method of Measurement (circle one) (s Hole depth: <u>76</u> Well dep Type of grout (circle one): Cement Casing length: <u>46</u> feet Casi Screen length: <u>30</u> feet Scree Screen slot size: <u>050</u> inches	bove of below (circle one) la teel tape electric tape pth:76 ' Bentonite Mix ng diameter:10 cen diameter:10 Setting depth: From	and surface Date measured: air line other: Well grouted to a depth of inches Type of casing: P inches Type of screen: P 47feet to	5-9-06 <u>10</u> feet <u>VC 160</u> <u>VC 160</u> <u>76</u> feet	
Static Water Level:  24'  feet at    Method of Measurement (circle one)  (a)    Hole depth:  76  Well depth    Type of grout (circle one):  Cement    Casing length:  46  feet  Casing    Screen length:  30  feet  Screen	bove of below (circle one) la teel tape electric tape pth:76 ' Bentonite Mix ng diameter:10 cen diameter:10 Setting depth: From Gravel packed Undern	and surface Date measured: air line other: Well grouted to a depth of inches Type of casing: P inches Type of screen: P 47feet to reamed Telescoped Oper	5-9-06 <u>10</u> fcet <u>VC 160</u> <u>VC 160</u> <u>76</u> feet hole Natural Development	
Static Water Level: <u>24</u> feet at Method of Measurement (circle one) (s Hole depth: <u>76</u> Well dep Type of grout (circle one): Cement Casing length: <u>46</u> feet Casi Screen length: <u>30</u> feet Scree Screen slot size: <u>050</u> inches	bove of below (circle one) la teel tape electric tape pth:76 ' Bentonite Mix ng diameter:10 cen diameter:10 Setting depth: From Gravel packed Undern	and surface Date measured: air line other: Well grouted to a depth of inches Type of casing: P inches Type of screen: P 47feet to	5-9-06 <u>10</u> fcet <u>VC 160</u> <u>VC 160</u> <u>76</u> feet hole Natural Development	
Static Water Level: <u>24</u> feet at Method of Measurement (circle one) (s Hole depth: <u>76</u> Well dep Type of grout (circle one): Cement Casing length: <u>46</u> feet Casi Screen length: <u>30</u> feet Scree Screen slot size: <u>050</u> inches	bove of below (circle one) la teel tape electric tape pth:76 ' Bentonite Mix ng diameter:10 sen diameter:10 Setting depth: From Gravel packed Undern Other (describe):	and surface Date measured: air line other: Well grouted to a depth of inches Type of casing: P inches Type of screen: P 47feet to reamed Telescoped Oper	5-9-06 <u>10</u> feet <u>VC 160</u> <u>VC 160</u> <u>76</u> feet hole Natural Developm	
Static Water Level: <u>24</u> feet at Method of Measurement (circle one) (st Hole depth: <u>76</u> Well dep Type of grout (circle one): Cement Casing length: <u>46</u> feet Casi Screen length: <u>30</u> feet Scree Screen slot size: <u>050</u> inches Type of completion (circle all applicable):	bove of below (circle one) la teel tape electric tape pth:76 ' Bentonite Mix ng diameter:10 sen diameter:10 Setting depth: From Gravel packed Undern Other (describe): feet. If tel	and surface Date measured: air line other: Well grouted to a depth of inches Type of casing: P inches Type of screen: P 47feet to reamed Telescoped Oper	5-9-06 <u>10</u> feet <u>VC 160</u> <u>VC 160</u> <u>76</u> feet hole Natural Developm reen, describe on back of particular	
Static Water Level: <u>24</u> 'feet at Method of Measurement (circle one) (st Hole depth: <u>76</u> Well dep Type of grout (circle one): Cement Casing length: <u>46</u> feet Casi Screen length: <u>30</u> feet Scree Screen slot size: <u>050</u> inches Type of completion (circle all applicable): Top of lap pipe or reduction in casing: Logs run (circle all applicable): No log run Name of organization running log(s):	bove of below (circle one) la teel tape electric tape pth:76 ' Bentonite Mix ng diameter:10 sen diameter:10 Setting depth: From Gravel packed Undern Other (describe): feet. If tel m) Electric Gamma Ray	and surface Date measured: air line other: Well grouted to a depth of inches Type of casing:P inches Type of screen: P 47feet to reamed Telescoped Oper escoped or more than one scr Density Sonic Neutron	5-9-06 <u>10</u> feet <u>VC 160</u> <u>76</u> feet hole Natural Development reen, describe on back of part Other:	
Static Water Level: <u>24</u> 'feet at Method of Measurement (circle one) (st Hole depth: <u>76</u> Well dep Type of grout (circle one): Cement Casing length: <u>46</u> feet Casi: Screen length: <u>30</u> feet Scree Screen slot size: <u>050</u> inches Type of completion (circle all applicable):	bove of below (circle one) la teel tape electric tape pth:76 ' Bentonite Mix ng diameter:10 sen diameter:10 Setting depth: From Gravel packed Undern Other (describe): feet. If tel m) Electric Gamma Ray	and surface Date measured: air line other: Well grouted to a depth of inches Type of casing:P inches Type of screen: P 47feet to reamed Telescoped Oper escoped or more than one scr Density Sonic Neutron	5-9-06    10    feet    VC  160    VC  160    76  feet    hole  Natural Development    reen, describe on back of part    Other:	
Static Water Level: <u>24</u> 'feet at Method of Measurement (circle one) (st Hole depth: <u>76</u> Well dep Type of grout (circle one): Cement Casing length: <u>46</u> feet Casi Screen length: <u>30</u> feet Scree Screen slot size: <u>050</u> inches Type of completion (circle all applicable): Top of lap pipe or reduction in casing: Logs run (circle all applicable): No log run Name of organization running log(s):	bove of below (circle one) la teel tape electric tape pth:76 ' Bentonite Mix ng diameter:10 cen diameter:10 Setting depth: From Gravel packed Undern Other (describe): feet. If tel m Electric Gamma Ray	and surface Date measured: air line other: Well grouted to a depth of inches Type of casing: P inches Type of screen: P feet to reamed Telescoped Oper escoped or more than one scr Density Sonic Neutron	5-9-06 <u>10</u> feet <u>VC 160</u> <u>76</u> feet hole Natural Development reen, describe on back of part Other:	
Static Water Level:  24'  feet at    Method of Measurement (circle one)  st    Hole depth:  76  Well deg    Type of grout (circle one):  Cement    Casing length:  46  feet    Screen length:  30  feet  Screet    Screen slot size:  050  inches    Type of completion (circle all applicable):  Top of lap pipe or reduction in casing:	bove of below (circle one) la teel tape electric tape pth:76 ' Bentonite Mix ng diameter:10 sen diameter:10 Setting depth: From Gravel packed Undern Other (describe): feet. If tel m) Electric Gamma Ray ructed, and completed in a and/or the Mississippi Dep	and surface Date measured: air line other: Well grouted to a depth of inches Type of casing: P inches Type of screen: P feet to reamed Telescoped Oper escoped or more than one scr Density Sonic Neutron	5-9-06 10 feet VC 160 VC 160 76 feet hole Natural Development reen, describe on back of pa Other:	
Static Water Level:  24' feet al    Method of Measurement (circle one)  static Water Level:    Hole depth:  76    Well depth:  76    Type of grout (circle one):  Cement    Casing length:  46    feet  Casi:    Screen length:  30    feet  Scree    Screen slot size:  050    inches  Type of completion (circle all applicable):    Top of lap pipe or reduction in casing:	bove of below (circle one) la teel tape electric tape pth:76 ' Bentonite Mix ng diameter:10 sen diameter:10 Setting depth: From Gravel packed Undern Other (describe): feet. If tel m) Electric Gamma Ray ructed, and completed in a and/or the Mississippi Dep	and surface Date measured: air line other: Well grouted to a depth of inches Type of casing: P inches Type of screen: P feet to reamed Telescoped Oper escoped or more than one scr Density Sonic Neutron	5-9-06 10 feet VC 160 VC 160 76 feet hole Natural Development reen, describe on back of pa Other:	

 If well telescopes please sketch below and show depths.


Ground Level

Desc	ription of Formations Encountered	Fr	om	То
Clay			0	19
Fine	Sand		20	25
Fine	Sand/gravel		26	$\overline{44}$
Med.	Sand/gravel Sand/gravel		45	73
Clay			74	76

H- 11

,

If more than one screen, show location of each on sketch

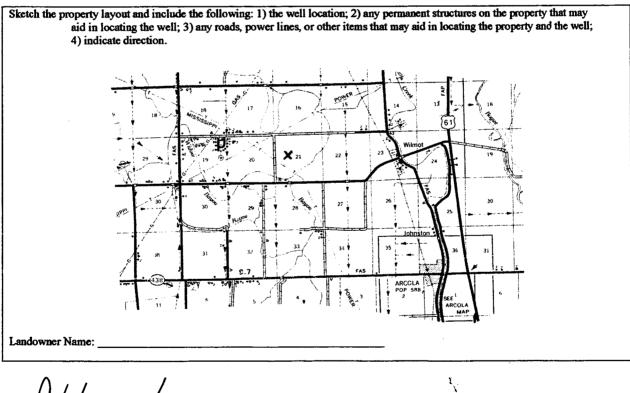

Signature of Water Well Contractor

	Equipment	Part 2 Pump Installer's Completion Report Mississippi Department of Environmental Quality Office of Land and Water Resources P.O. Box 10631		Aquifer: Well #: <u>H-</u> ZC
Date completed: <u>5-8-06</u> Copy information from block on Part 1		(601	Jackson, MS 39289-0631 (601)961-5210 (601)354-6938 (fax)	
This part of the rep	ort must be complete	d by a licensed water well filed with the Department	contractor or a licensed pump at the above address within 31	p installer. A copy of Part 1 of t I days of well completion.
report must be attached and both parts filed with the Department Well Owner Information		Well Location		
Owner Name:	Isola Plar	itation	Latitude:	Longitude:
Mailing Address:	Rt.1, Box 349		Method of Lat/Long (check	cone): Conventional Survey
			USGS quad, Hand-he	eld GPS, Survey-grade GPS_
	Leland, MS	38756 Zin Code	¼¼ Sec_	21 <sub>T</sub> 17N <sub>R</sub> 7W
Ci Ci	ity Said		Distance Direction	
Telephone No. (	_)		6Miles	_of
	Pump Type Circle one			Power Type Circle one
Air Lift	Jet	Submersible	Diesel Engine Gase	oline Engine Natural G
Bucket	Piston	Turbine	Electric Motor Har	nd Tractor P1
Centrifugal	Rotary	Flowing Well	Windmill Oth	er (specify):
	· · · · · · · · · · · · · · · · · · ·		Horse Power Rating of Mo	tor: <u>20</u>
Date Pump Installed	5-9-06		Setting Depth:	60 feet
Rated Pump Capacit	y:950	Gallons Per Minute	Number of Stages:1	
	Pump Test Dat	a	Method of	Measuring Water Level
Date Well Tested: _				Circle one
Static Water Level (	A): Fe	et Below Land Surface		Measuring Line Steel Tap
		et Below Land Surface	Other (specify):	
Drawdown [(B) - (A	()]:Fe	et Below Land Surface	For flowing well, measure	d shut in head:f
Test Pumping Rate:		Gallons Per Minute	Well yielded	GPM with a drawdown of
Duration of Pump T	est (minimum 4 hour	s):hours	feet afte	hours of pump
	<b>Y that the above stat</b> M. Chism	ements are true to the best 0695	of my knowledge.	h

· · · · · · · · ·