| | State VI | all Danort | | | | | |
|---|---|-------------------------------------|---------------------------|----------------|--|--|--|
| | | ell Report | For Office Use O | nly: | | | |
| County: Washington Missi | Part 1 – Driller's Log | | A | - | | | |
| Permit #: 0 (1 4 2 7 4 1 | Mississippi Department of Environmental Quality Office of Land and Water Resources | | Aquifer: | 78 | | | |
| Driller: Charles M. Nichols | P.O. Box 10631 Jackson, MS 39289-0631 | | Well #: | | | | |
| Date drilling completed: <u>6-14-08</u> | • | 961-5210 | L. S. Elevation: | | | | |
| | (601)354 | 4-6938 (fax) | E-log #: | | | | |
| State Law requires that this report be prepared by the license holder responsible for the work and filed with the Department at the above address within 30 days of completion of drilling of the well or borehole. | | | | | | | |
| Information on Well Owner (Landowner if borehole is not for a wat | tor well | Well or Bo | rehole Location | | | | |
| Owner Name ARLO Nightin | he ARLO NighTINGALE | | V Longitude: 090 56 | 1047W | | | |
| Mailing Address: 2555 Arow De | ACT A GI Method of Lat/Long (circle or | | ne): Conventional Surve | Y. | | | |
| | | USGS quad, Hand-held | | | | | |
| HollANJALE MS | 38749 | 5 W 1/4 Nor 1/4 Sec 9 | | Zur | | | |
| City State Zip Code Distance Direction | | | | | | | |
| Telephone No. () | | | | | | | |
| | Well / Bore | | | | | | |
| Date drilling started: <u>6-14-08</u> Date drilling co | ompleted: <u>6-14</u> | -08 Hole depth: 83 | Hole diameter. 26 | | | | |
| Location of the source of any surface water used a Method of dosing and volume of Chlorine used in | | | ······ | | | | |
| Logs run (circle all applicable): No log rup Elec Name of organization running log(s): | stric Gamma Ray | Density Sonic Neutron | Other: | | | | |
| Purpose of borehole (check one): Water Well | Geotechnical/Geolo | ogical Investigation Ground | Source Heat Pump | | | | |
| Seismic Survey | Other (describe) er_well construction |) skip the remainder of this bla | ock | | | | |
| Purpose of Well (check one): Home Industria | u Public Supply | Irrigation / Fish Culture | Other: | _ | | | |
| If a flowing well, method of flow regulation: Valv | ve O | ther (describe) | | | | | |
| Static Water Level: 14 feet above get | below (circle one) h | and surface Date measured: | 6-14-08 | _ | | | |
| Method of Measurement (circle one) steel tape | electric tape | air line other: | | _ | | | |
| Well depth: <u>\$3</u> Well grouted to a depth of | <u>/D_</u> feet Type | of grout (circle one): Neat em | end Bentonite Mix | | | | |
| Casing length: <u>43</u> feet Casing diam | eter. <u>16</u> | _inches Type of casing: | puc | | | | |
| Screen length: <u>40</u> feet Screen diam | neter: <u>16</u> | _inches Type of screen: | pre | | | | |
| Screen slot size: <u>, 0.35</u> inches Sett | | | • | | | | |
| Type of completion (circle all applicable): Grave | el packed Under | eamed Telescoped Open | hole Natural Develop | ment | | | |
| Other | r (describe); | | | | | | |
| Top of lap pipe or reduction in casing: | feet. <u>If tel</u> | escoped or more than one scree | zn, describe on next page | 2 | | | |
| Replacement well. | ······································ | | Form: OLW | R-SWR-1A | | | |
| | | | | BECEIVE | | | |
| | | | | NEVEIVEL | | | |
| | | | | | | | |

. .

JUL 2 3 2008 BY: OLWR

* #

QUU127111

The sketch below only required for water wells


If well telescopes, show depths on sketch. Ground Level.

| Description of formations encountered must be provided for all |
|--|
| wells and boreholes, unless specifically exempted by regulations |

H-208

| Clan | Ground Level | To (depti |
|--|--------------|-------------|
| med sand course sand Course sand - little p-grove Cemented gravel | 35 | 40 |
| COURSE SANC | 40 | 50 |
| Course sand - little same | 150 | 83 |
| Cemented a church | 83 | |
| | | <u></u> |
| | | <u> </u> |
| | | |
| | | |
| | | ↓ ·· |
| · · · · · · · · · · · · · · · · · · · | | |
| | + | <u> </u> |
| | | |
| | | <u> </u> |
| | | |
| | | |
| | | |
| | | 1 |
| | | |
| | | |
| | | 1 |
| | | <u> </u> |
| | | t |
| | | + |

If more than one screen, show location of each on sketch

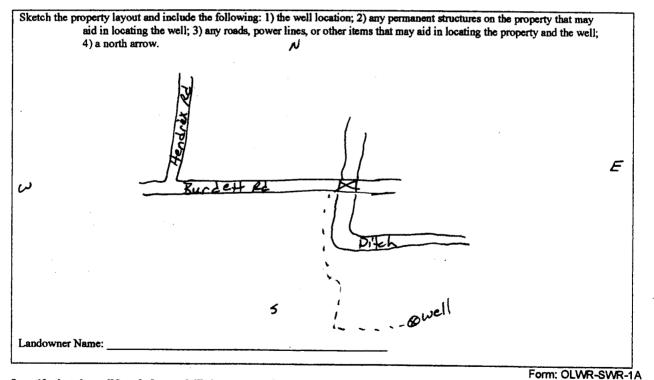

I certify that the well/borehole was drilled, constructed, and completed in accordance with all applicable requirements of the Mississippi Department of Environmental Quality and the Mississippi Department of Health regulations, if applicable, and state

Date

laws. Charles M. Dichols 0-0607 7-22-08

A. Julos Charles RECEIVED Signature of Licené

Print Name of Responsible Licensee and License No.

JUL 2 3 2008 BY: OLWR

| STATE WELL REPORT | | | | | | |
|---|--|--|--|--|--|--|
| Driller: Charles M. Nichols Date completed: <u>6 - 16 - 08</u> <u>Covy information from block on Part 1</u> This part of the report must be completed by a | Part 2 Pump Installer's Completion Report Mississippi Department of Environmental Qu Office of Land and Water Resources P.O. Box 10631 Jackson, MS 39289-0631 (601)961-5210 (601)354-6938 (fax) I by a licensed water well contractor or a license | | For Office Use Only: Aquifer: Well #: <u>H - 208</u> Elevation: D installer. A copy of Part 1 of the | | | |
| report must be attached and both parts filed w Well Owner Information | ith the Department a | t the above address within 3 | 9 days of well completion. Vell Location | | | |
| Owner Name: ARLD Night, Mailing Address: 2555 AVE | Ngale Darlove | Latitude: <u>33 20, 234</u> Method of Lat/Long (check | N Longitude: 090 56,049W | | | |
| Hollows Ale MS City State | • | ¼¼ Sec_ | Id GPS Survey-grade GPS T R Nearest Town of Leland | | | |
| | | | | | | |
| Pump Type Circle one | | J | Power Type Circle one | | | |
| Air Lift Jet Sul | omersible | Diesel Engine Gaso | line Engine Natural Gas | | | |
| Bucket Piston Tur | tine | Electric Motor Han | d Tractor PTO | | | |
| Centrifugal Rotary Flo | wing Well | Windmill Othe | r (specify): | | | |
| Other (specify): <u>Customers pump</u> Date Pump Installed: <u>6-/6-08</u> Rated Pump Capacity: <u>Galle</u> | | Horse Power Rating of Mot Setting Depth: | | | | |
| Pum p Test Data | | Method of M | leasuring Water Level | | | |
| Date Well Tested: Static Water Level (A):Feet Below Pumping Water Level (B):Feet Below | w Land Surface v Land Surface | Air Line Electric Me Other (specify): | Circle one easuring Line Steel Tape | | | |
| Drawdown [(B) – (A)]:Feet Below | 1 | For flowing well, measured | | | | |
| Test Pumping Rate:Gallo | | | GPM with a drawdown ofhours of pumping | | | |
| I HEREBY CERTIFY that the above statements are true to the best of my knowledge. <u>Charles M. Nichols 0-0667</u> Print Name of Pump Installer and License No. (if applicable) Signature of Pump Installer Form: OLWR SWR 10 ED | | | | | | |

JUL 2 3 2008 BY: OLWR

.