

WASHINGTON

H 2000

MISSISSIPPI BOARD OF WATER COMMISSIONERS 416 North State Street Jackson, Mississippi 39201

WATER WELL DRILLERS LOG

5/24 1978 Bailey Drilling Co. Washington date well completed firm name county well located

LANDOWNER: David Hanagan Leland, Miss (mailing address)

WELL LOCATION: sec. 2 T 17 N R 7 E S W 4 miles SE of Leland (distance) (direction) (nearest town)

WELL PURPOSE: Farm (home, irrigation, municipal, industrial)


- WELL COMPLETION DATA: (1) diameter (inches) 4x2 1/2 (2) total depth (feet) 466 (3) static water level (feet) 30 below top of ground. (4) casing steel, 446 (material) (depth) 4x2 1/2 If telescope see back. (size) (5) screen 20ft, 446 (length) (depth to top) 2 1/2, stainless steel (size) (material) (6) pump 1/2, 25 (HP) (yield gpm) Electric (type power) (7) electric log no (yes or no)

(organization running log)

(8) how well bottom plugged Back pressure valve

DRILLERS REMARKS:


Table with 3 columns: description of formations encountered, from, to. Rows include Clay (0-50), Sand (50-90), Gravel (90-130), Mud (130-400), Muck Sand (400-420), Sand (420-466).

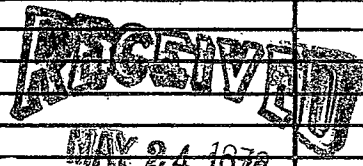

MISS. BD. OF WATER COMM

If well telescopes please sketch and show depths.

GROUND LEVEL

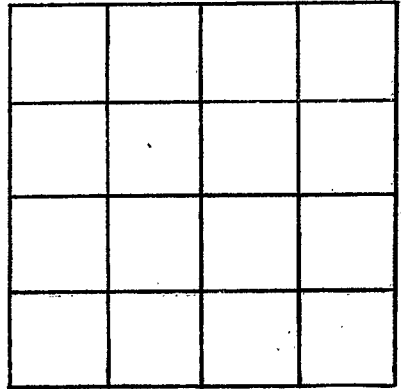

SECTION \_\_\_\_\_

Please indicate well location X.

ADDITIONAL INFORMATION

If more than one screen,  
show locations of each on sketch.