

WASHINGTON

H

2001

5-15-78

MISSISSIPPI BOARD OF WATER COMMISSIONERS
416 North State Street
Jackson, Mississippi 39201

WATER WELL DRILLERS LOG

5-15

1978

Schultz Drilling Co Washington

date well completed

firm name

county well located

LANDOWNER: J.V. Boatwright

Wilmington Road

Greenville, MS.
(mailing address)

WELL LOCATION:

sec. 22 T. 17 N. R. 7 E. S. 7 W. Leland
(distance) miles (direction) of (nearest town)

WELL PURPOSE: home
(home, irrigation, municipal, industrial)

WELL COMPLETION DATA:

- (1) diameter (inches) 4" X 2"
- (2) total depth (feet) 400
- (3) static water level (feet) 29 below top of ground
- (4) casing PVC 370 (material) (depth)
- (5) screen 30' 370' (length) (depth to top)
- 2" PVC (size) (material)
- (6) pump 1 (HP) 19 (yield gpm)
- ele. (type power)
- (7) electric log NO (yes or no)

(organization running log)

(8) how well bottom plugged B/W

DRILLERS REMARKS:

description of formations encountered	depth	
	from	to
Clay	0	20
Sand	20	74
Clay	74	140
Sandy Shale	140	300
Sand	300	400

RECEIVED
JUN 12 1978
MISS. BD. OF WATER COMM.


If well telescopes please sketch and show depths.

GROUND LEVEL

4 in
PVC
120 ft

2 in
PVC
250 ft

2 in
PVC
Screen
30 ft

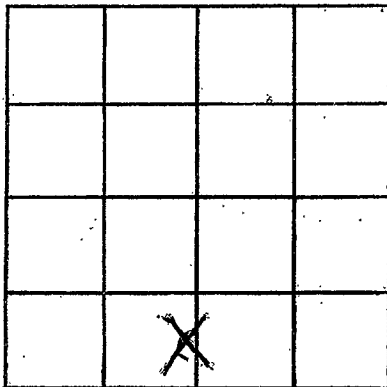

SECTION 22

Please indicate well location X.

ADDITIONAL INFORMATION

If more than one screen,
show locations of each on sketch.