

WASHINGTON

H 2022

5-20-78

MISSISSIPPI BOARD OF WATER COMMISSIONERS  
416 North State Street  
Jackson, Mississippi 39201

WATER WELL DRILLERS LOG

5-20  
date well completed

1978 Schultz Drilling Co.  
firm name

Washington  
county well located

LANDOWNER: Kenneth Ray

Wilmore Rd

Greenville MS.  
(mailing address)

WELL LOCATION:

sec: 18 T 170 N R 7 E  
6 miles SE of Greenville  
(distance) (direction) (nearest town)

WELL PURPOSE: home  
(home, irrigation, municipal, industrial)

WELL COMPLETION DATA:

(1) diameter (inches) 2 in  
(2) total depth (feet) 430 ft  
(3) static water level (feet) 23 below above  
top of ground

(4) casing 2 in PVC 2 in  
(material) (depth)

(size) if telescope see back.

(5) screen 10 ft 420  
(length) (depth to top)

2 in PVC  
(size) (material)

(6) pump 1 10  
(HP) (yield gpm)

elo  
(type power)

(7) electric log NO  
(yes or no)

(organization running log)

(8) how well bottom plugged b/w

description of formations encountered

from to

Clay	0	18
Sand	18	93
Clay	93	120
Sandy Silt	120	370
Sand	370	430


DRILLERS REMARKS:

RECEIVED  
JUN 12 1978

MISS. BD. OF WATER COMMISSIONERS

If well telescopes please sketch and show depths.

GROUND LEVEL

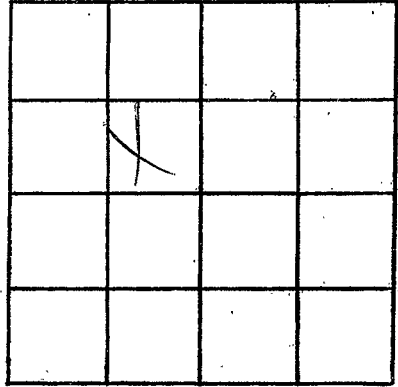

SECTION 12

Please indicate well location X.

ADDITIONAL INFORMATION

If more than one screen, show locations of each on sketch.