

WASHINGTON
 H 2003
 5-10-78

MISSISSIPPI
 BOARD OF WATER COMMISSIONERS
 416 North State Street
 Jackson, Mississippi 39201

WATER WELL DRILLERS LOG

10 May 1978 Lambert Drilling Wash
 date well completed firm name county well located

LANDOWNER:
 Joe Fratesi
 Leland, Miss.
 (mailing address)

WELL LOCATION:
 sec. 15 T 17 N R 7 E
 6 miles S of Leland
 (distance) (direction) (nearest town)

WELL PURPOSE: home
 (home, irrigation, municipal, industrial)

- WELL COMPLETION DATA:
- (1) diameter (inches) 4x2
 - (2) total depth (feet) 425
 - (3) static water level (feet) 35 below top of ground.
 - (4) casing PVC 405 (material) (depth)
 4x2 (size) if telescope see back.
 - (5) screen 20 425-405 (length) (depth to top)
 2' PVC (size) (material)
 - (6) pump 1 20 (HP) (yield gpm)
 elect (type power)
 - (7) electric log (yes or no)
 - (organization running log)
 - (8) how well bottom plugged back press.

description of formations encountered	from	to
Clay	0	30
Sand	30	90
pea gravel	90	140
Sand & gravel	140	225
Clay	225	265
rock	265	266
Clay & Silt Sand	266	360
Sand	360	425

RECEIVED
 SEP - 8 1978

MISS. BD. OF WATER COMMISSIONERS

DRILLERS REMARKS:

If well telescopes please sketch and show depths.

GROUND LEVEL

140


411

405

2"

425

2" screen

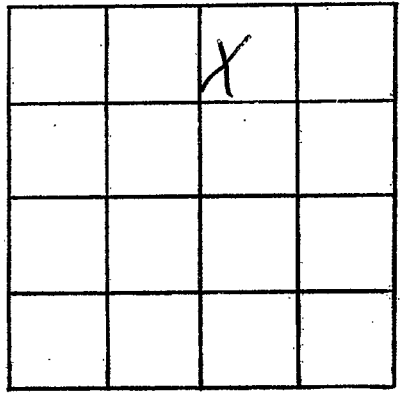

SECTION 15

Please indicate well location X.

ADDITIONAL INFORMATION

If more than one screen, show locations of each on sketch.