

WASHINGTON

H 2004

8-07-78

MISSISSIPPI BOARD OF WATER COMMISSIONERS 416 North State Street Jackson, Mississippi 39201

WATER WELL DRILLERS LOG

Aug 7, 1978 Schultz Drilling Co. Washington date well completed firm name county well located

LANDOWNER: Jack Taylor

Wilcox Rd

Greenville, MS 38701 (mailing address)

description of formations encountered

from

to

Clay 0 18 Med Sand 18 30 Coarse Sand 30 50

WELL LOCATION:

sec. 7 T 17 N R 7 E 9 miles SE of Greenville (distance) (direction) (nearest town)

WELL PURPOSE: HOME (home, irrigation, municipal, industrial)

WELL COMPLETION DATA:

- (1) diameter (inches) 2 1/2 (2) total depth (feet) 50 (3) static water level (feet) 14 below above top of ground. (4) casing PVC 40 (material) (depth) 2 (size) if telescope see back. (5) screen 10 40 (length) (depth to top) 2 (size) PVC (material) (6) pump X X (HP) (yield gpm) X (type power) (7) electric log NO (yes or no)

(organization running log)

(8) how well bottom plugged PVC Cap


DRILLERS REMARKS:

RECEIVED AUG 27 1978

MISS. Bd. OF WATER COMMISSIONERS

If well telescopes please sketch and show depths.

GROUND LEVEL

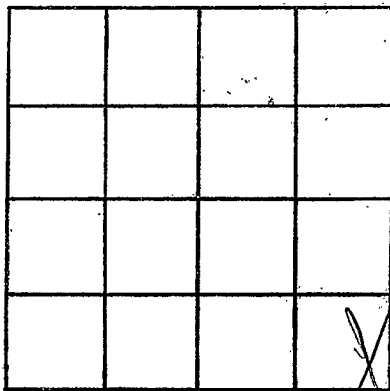

SECTION \_\_\_\_\_

Please indicate well location X.

ADDITIONAL INFORMATION

If more than one screen, show locations of each on sketch.