

WASHINGTON

H 2005

9-12-78

MISSISSIPPI BOARD OF WATER COMMISSIONERS
416 North State Street
Jackson, Mississippi 39201

WATER WELL DRILLERS LOG

Sept. 12, 1978 Schultz Drilling Co. Washington
date well completed firm name county well located

LANDOWNER: Fred Ballard Jr.

Hwy. 61 S.
Leland MS. 38756
(mailing address)

WELL LOCATION:

sec. 32 T 17 N R 7 E
4 miles West of Arcola
(distance) (direction) (nearest town)

WELL PURPOSE: Home
(home, irrigation, municipal, industrial)

WELL COMPLETION DATA:

- (1) diameter (inches) 4" X 2"
- (2) total depth (feet) 470 ft
- (3) static water level (feet) 29 below above top of ground.
- (4) casing PUC 450' (material) (depth)
4" X 2" (size) If telescope see back.
- (5) screen 20' 450' (length) (depth to top)
2" (size) PUC (material)
- (6) pump 3/4 20 (HP) (yield gpm)
E/E. (type power)
- (7) electric log NO (yes or no)

(organization running log)

(8) how well bottom plugged b/w

DRILLERS REMARKS:



description of formations encountered	depth	
	from	to
Clay	0	20
Sand	20	40
Coarse Sand + Pea gravel	40	95
Clay	95	160
Sandy Shale	160	400
Med. Sand	400	440
COARSE SAND	440	470

RECEIVED
DEC 27 1978

MISS. BD. OF WATER COMMISSIONERS

If well telescopes please sketch and show depths.

GROUND LEVEL

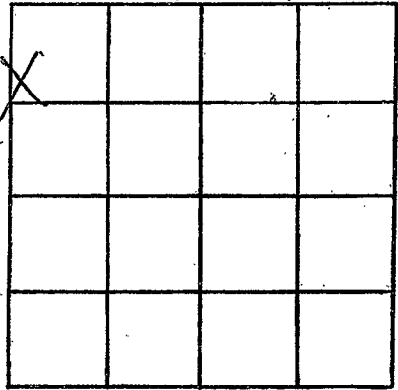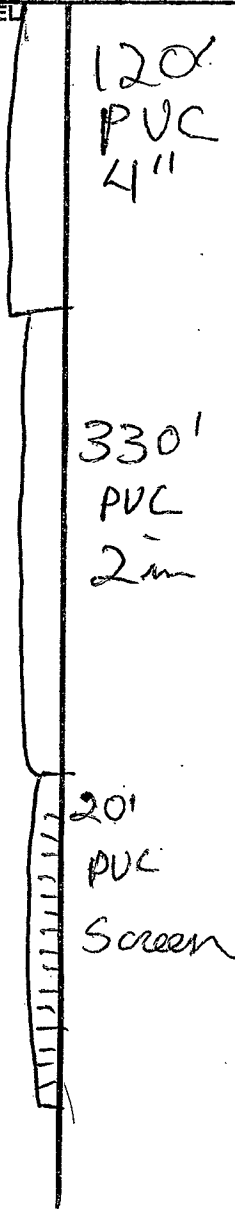

SECTION _____

Please indicate well location X.

ADDITIONAL INFORMATION

A series of horizontal lines for entering additional information.

If more than one screen, show locations of each on sketch.