

Washington
H 2000

MISSISSIPPI
BOARD OF WATER COMMISSIONERS
416 North State Street
Jackson, Mississippi 39201

7-3-77

WATER WELL DRILLERS LOG

July 3 1977 Schultz Drilling Co Washington
date well completed firm name county well located

LANDOWNER: Presley Carter
W. I. Mont Road
Greenville MS
(mailing address)

description of formations encountered	from	to
CLAY	0	20
SAND + pea gravel	20	28
CLAY	28	240
SANDY SHALE	240	400
SAND	400	490

WELL LOCATION:
sec. 30 T. 17 N. R. 7 E. S. 10
10 miles S of Leland
(distance) (direction) (nearest town)

WELL PURPOSE: HOME
(home, irrigation, municipal, industrial)


WELL COMPLETION DATA:
(1) diameter (inches) 2 1/2
(2) total depth (feet) 490
(3) static water level (feet) 32' below top of ground.
(4) casing PVC 480'
(size) if telescope see back.
(5) screen 10' 480'
(length) (depth to top)
2 1/2" PVC
(size) (material)
(6) pump 1 9
(HP) (yield gpm)
elc
(type power)
(7) electric log NO
(yes or no)
(organization running log)
(8) how well bottom plugged b/w

DRILLERS REMARKS:

Need 9-25-77
done

If well telescopes please sketch and show depths.

GROUND LEVEL

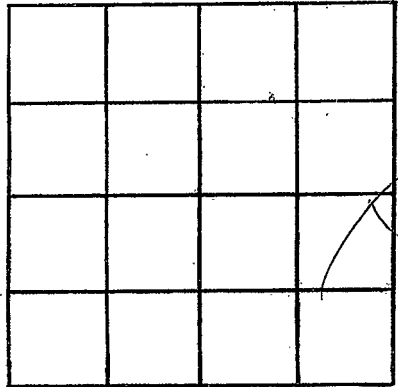

SECTION _____

Please indicate well location X.

ADDITIONAL INFORMATION

If more than one screen, show locations of each on sketch.