

Wash.
 H 2007
 6-26-79

MISSISSIPPI
 BOARD OF WATER COMMISSIONERS
 416 North State Street
 Jackson, Mississippi 39201

WATER WELL DRILLERS LOG

6-26 1979 Schultz Drilling Co Washington
 date well completed firm name county well located

LANDOWNER: Cottingham
Wilmont Rd.
Greenville MS
 (mailing address)

description of formations encountered	from	to
CLAY	0	20
SAND + pea gravel	20	173
CLAY	173	360
SAND	360	470

WELL LOCATION:
 sec. 23 T. 17 N. R. 7 W. E.
8 miles S of Labon
 (distance) (direction) (nearest town)

WELL PURPOSE: Home
 (home, irrigation, municipal, industrial)



WELL COMPLETION DATA:
 (1) diameter (inches) 4" X 2"
 (2) total depth (feet) 470'
 (3) static water level (feet) 35 below above top of ground.
 (4) casing PVC 450'
 (material) (depth)
 (size) If telescope see back.
 (5) screen 20' 450'
 (length) (depth to top)
2" PVC
 (size) (material)
 (6) pump 1" 18 gpm
 (HP) (yield gpm)
eb
 (type power)
 (7) electric log NO
 (yes or no)
 (organization running log)
 (8) how well bottom plugged b/w

see 9-25-79

DRILLERS REMARKS:

If well telescopes please sketch and show depths.

GROUND LEVEL

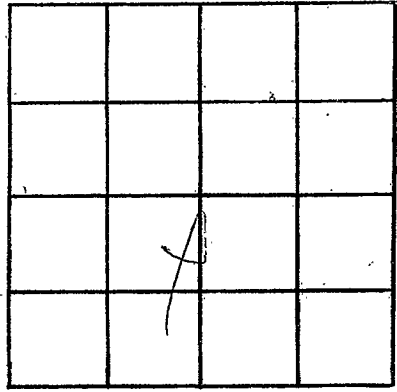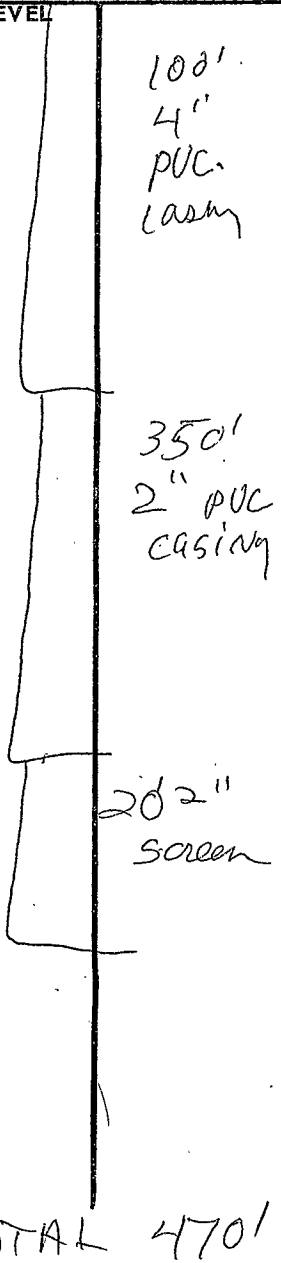

SECTION _____

Please indicate well location X.

ADDITIONAL INFORMATION

Lined area for additional information.

If more than one screen, show locations of each on sketch.