

Wash.
H 2008
8-8-79

MISSISSIPPI
BOARD OF WATER COMMISSIONERS
416 North State Street
Jackson, Mississippi 39201

WATER WELL DRILLERS LOG

8 Aug date well completed 1979 Lambert Drilling Co. firm name Wash county well located

LANDOWNER:	description of formations encountered	from	to
Eddie Arendale Greenville, Miss. (mailing address)			
WELL LOCATION: sec. 19 T. 17 N. R. 7 E 12 miles S/E of Greenville (distance) (direction) (nearest town)	sand	18	65
WELL PURPOSE: home (home, irrigation, municipal, industrial)	pea gravel	65	94
WELL COMPLETION DATA: (1) diameter (inches) 2 (2) total depth (feet) 515 (3) static water level (feet) 34 below above top of ground. (4) casing PVC, 505 (material) (depth) If telescope see back. (size) (5) screen 10, 505-505 (length) (depth to top) 2" PVC (size) (material) (6) pump 1 (HP) 10 (yield gpm) elect (type power) (7) electric log (yes or no) (organization running log) (8) how well bottom plugged back press.	blue shell	94	310
	clay st sand	310	390
	sand. pine	390	480
	sand good	480	515
DRILLERS REMARKS:			


DEPT. OF NATURAL RESOURCES
BUREAU OF LAND & WATER RESOURCES

JAN 9 1980

RECEIVED

If well telescopes please sketch and show depths.

GROUND LEVEL

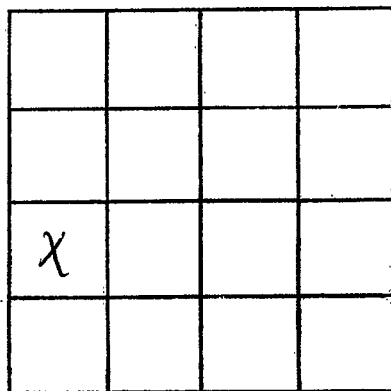

SECTION 19

Please indicate well location X.

ADDITIONAL INFORMATION

If more than one screen, show locations of each on sketch.