

Washington  
H 2011  
4/17/80

MISSISSIPPI  
BOARD OF WATER COMMISSIONERS  
416 North State Street  
Jackson, Mississippi 39201

WATER WELL DRILLERS LOG

17 apr date well completed      1980 Lambort Drilling Co. firm name      Wash county well located

LANDOWNER:	description of formations encountered	from	to
Jerry Gammell Greenville miss. (mailing address)			
WELL LOCATION:	Sand	15	40
sec. 8 T. 17 N. R. 7 E 8 miles SE of Greenville (distance) (direction) (nearest town)	Sand course	40	75
WELL PURPOSE: home (home, irrigation, municipal, industrial)	Pea gravel	75	87
WELL COMPLETION DATA:	blue Clay	87	190
(1) diameter (inches) 2	Clay & sand	190	315
(2) total depth (feet) 460	Sand med	315	390
(3) static water level (feet) 31 below top of ground.	Sand good.	390	460
(4) casing PVC, 450 (material) (depth)			
2 (size) If telescope see back.			
(5) screen 10 (length), 460-450 (depth to top)			
2' (size), BS (material)			
(6) pump 1 (HP), 10 (yield gpm)			
elect (type power)			
(7) electric log (yes or no)			
(organization running log)			
(8) how well bottom plugged back press			
DRILLERS REMARKS:			


DEPT. OF NATURAL RESOURCES  
BUREAU OF LAND & WATER RESOURCES

MAY 29 1980

RECEIVED

If well telescopes please sketch and show depths.

GROUND LEVEL

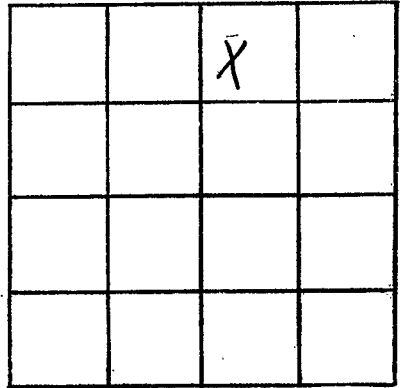

SECTION 8

Please indicate well location X.

ADDITIONAL INFORMATION

If more than one screen,  
show locations of each on sketch.