

Wash.

MISSISSIPPI  
BOARD OF WATER COMMISSIONERS  
416 North State Street  
Jackson, Mississippi 39201

WATER WELL DRILLERS LOG

Schultz Drilling Co.

Wash.

H 2012  
6-1-80

6-1-80

19

firm name

county well located

LANDOWNER: Freddie Morris

Willmont Rd

Greenville MS

(mailing address)

WELL LOCATION:

sec. 18 T. 17 N. R. 7 E. S. 6  
6 miles SE of Greenville  
(distance) (direction) (nearest town)

WELL PURPOSE:

(home, irrigation, municipal, industrial)

WELL COMPLETION DATA:

- (1) diameter (inches) 2 1/2
- (2) total depth (feet) 440
- (3) static water level (feet) 29 below top of ground.
- (4) casing PVC 430 (material) (depth)

(size) if telescope see back.

- (5) screen 10 430 (length) (depth to top)
- 2" PVC (size) (material)

- (6) pump 1 10 (HP) (yield gpm)
- ele (type power)

- (7) electric log NO (yes or no)

(organization running log)

- (8) how well bottom plugged b/w

description of formations encountered

from

to

CLAY	0	20
SAND	20	95
Clay	95	130
SANDY SHALE	130	370
SAND	370	440

DEPT. OF NATURAL RESOURCES  
BUREAU OF LAND & WATER RESOURCES


JUL - 2 1980

DRILLERS REMARKS:

RECEIVED

If well telescopes please sketch and show depths.

GROUND LEVEL

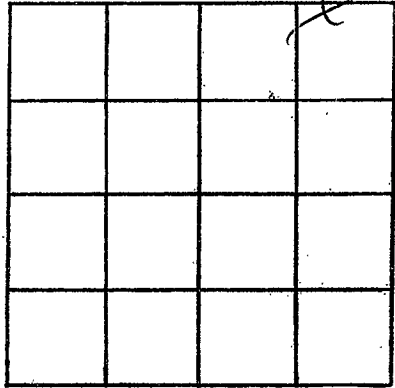

SECTION \_\_\_\_\_

Please indicate well location X.

ADDITIONAL INFORMATION

If more than one screen,  
show locations of each on sketch.